

Client:
National Highway Authority
Ministry of Communication
Government of Pakistan

Consultant:
Remarried S.A.
ENGINEERING CONSULTANTS
PUNJAB, INDIA





Contractor:
Xinjiang Beishan Road &
Bridge Group Co., Ltd


Project:
Motorway (M-4) Package-IIA Gofra-Jamrud


Title:
AS BUILT DRAWING OF GENERATOR ROOM
FLOOR PLAN, SECTION & ELEVATION

Submitted:
Ref No RS444/2017/8/9

Approved:

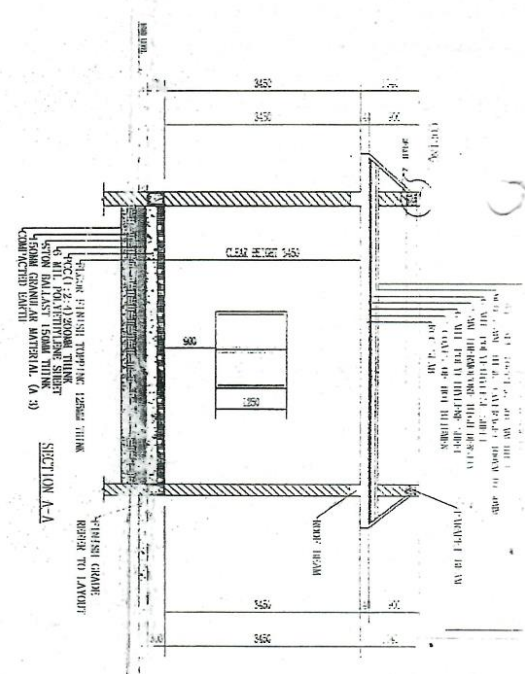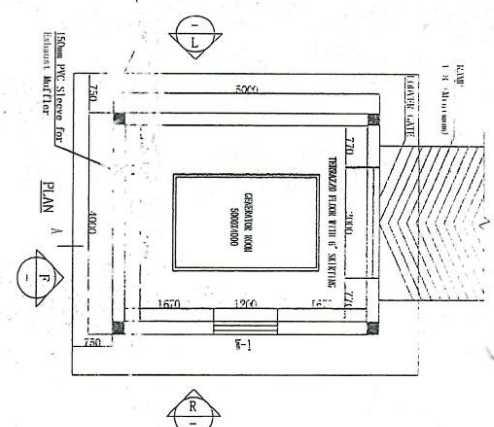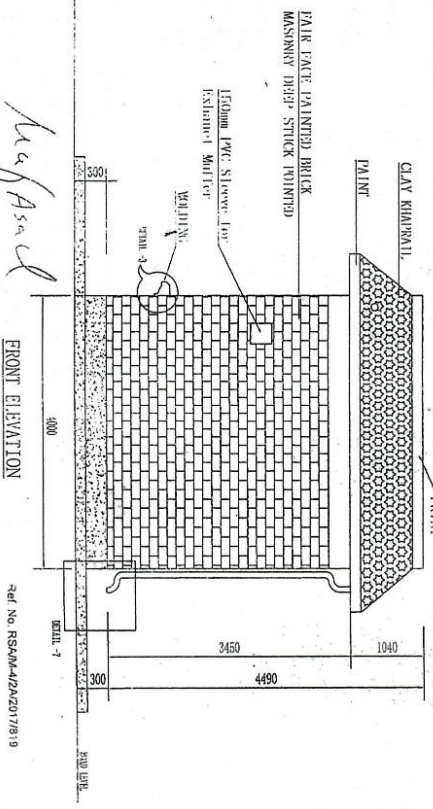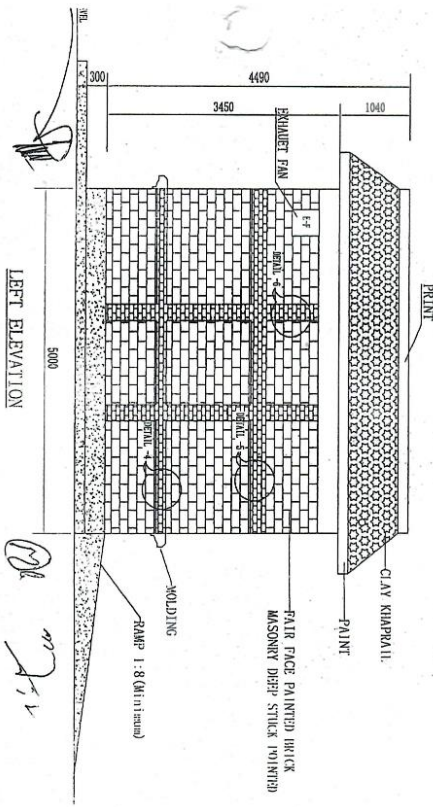

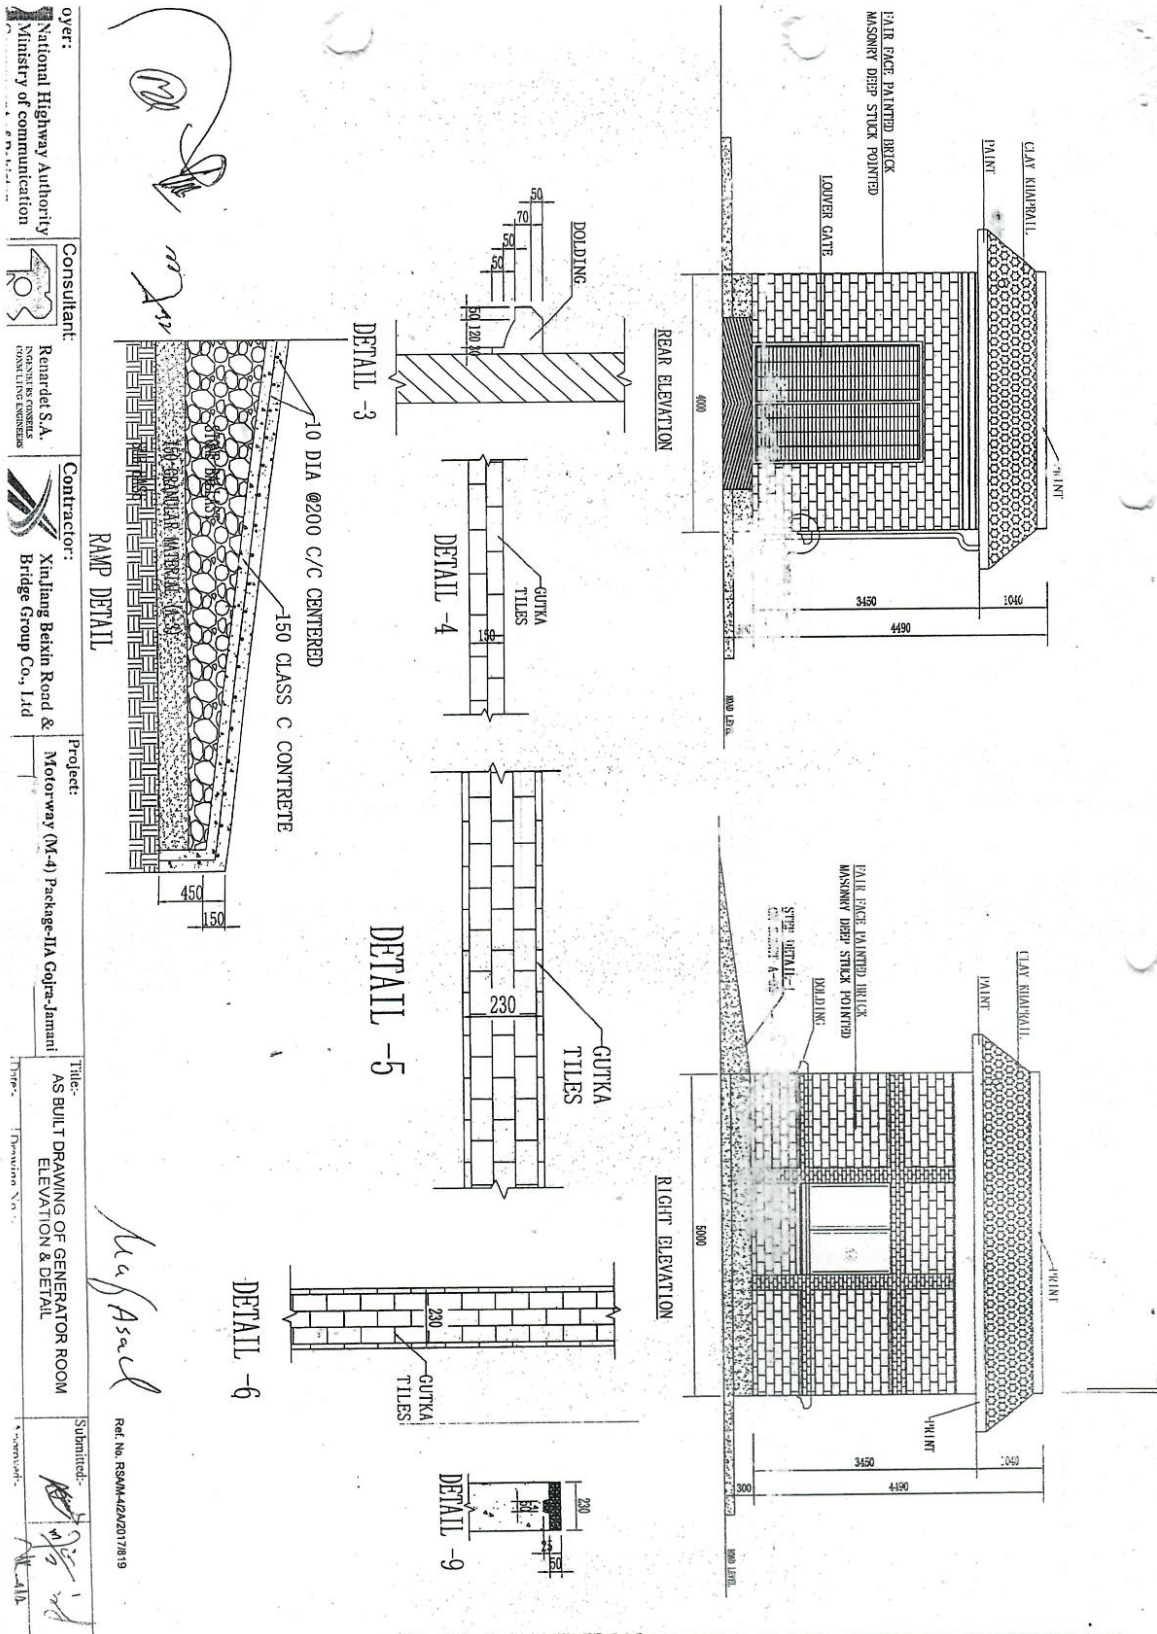

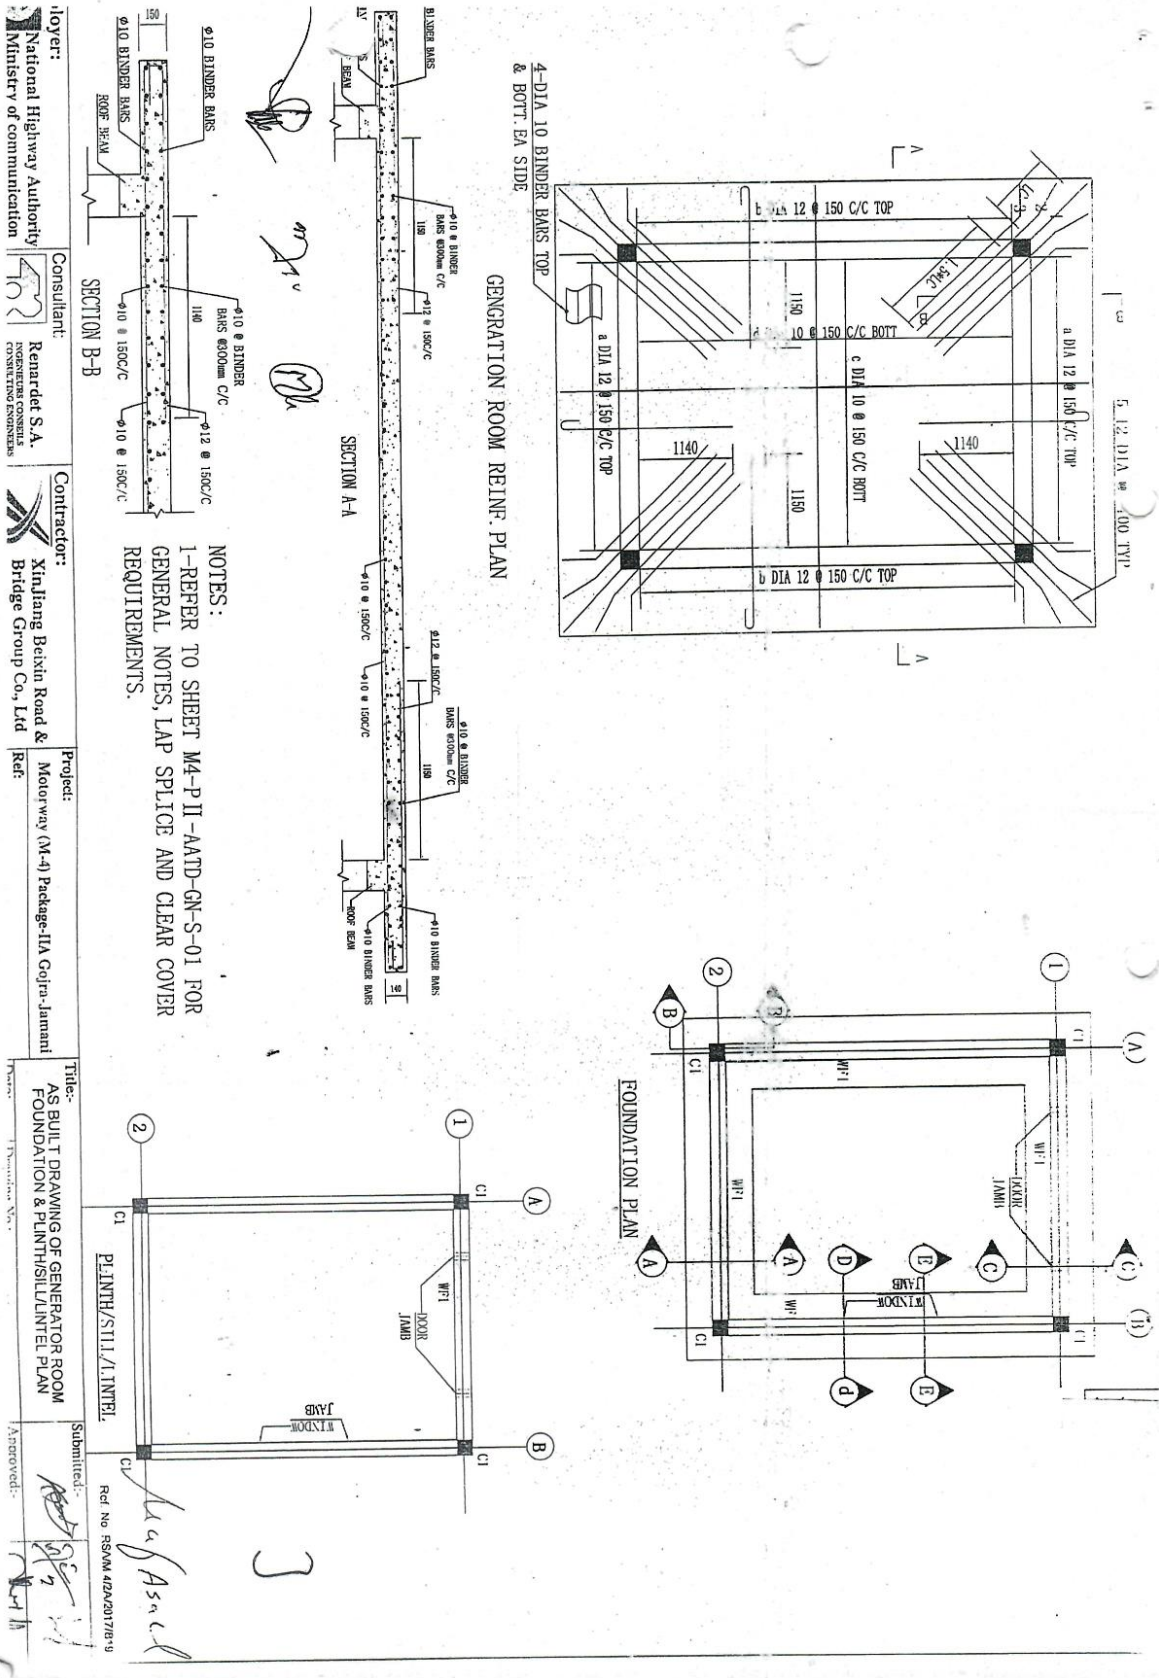

Owner:
National Highway Authority
Ministry of communication
Government of Pakistan

Consultant:
Remarcel S.A.
INGENIEROS CONSULTORES
CONSTRUCTIVOS E INGENIERIA

Contractor:
Xinjiang Baixin Road &
Bridge Group Co., Ltd

Project:
Motorway (M-4) Package-IIA Gajra-Jamari

Title:
AS BUILT DRAWING OF GENERATOR ROOM
ROOF PLAN

Submitted:
Ref. No. RSAM-4242017/19


Approved:
[Signature]

ABBREVIATION	
L.P	MEANS 0" ABOVE MIN. 50 MUD
I.P1	MEANS 25" ABOVE MIN. 50 MUD
I.P2	MEANS 50" ABOVE MIN. 50 MUD

[Signature]

DETAIL-11

[Signature]

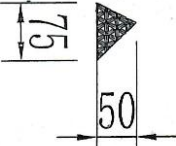


DETAIL-10


Ref. No. RSAM-4242017/19

[Signature]


ROOF PLAN

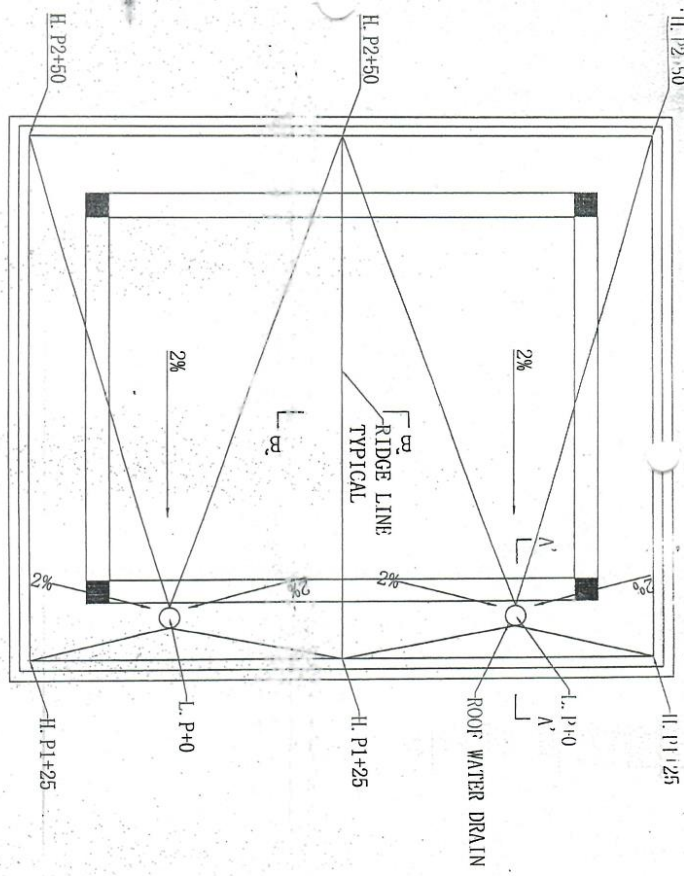

SECTION B'-B'

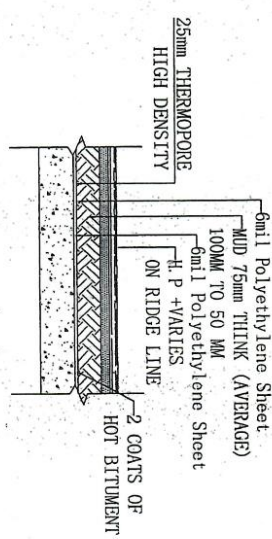


SECTION A'-A'

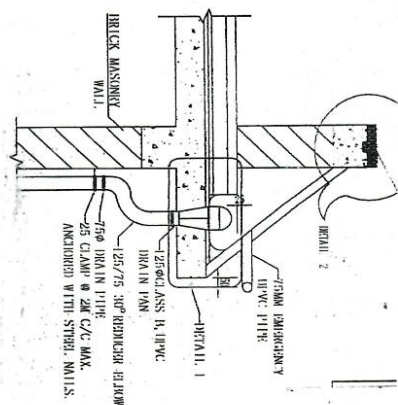


Client:	National Highway Authority Ministry of Communication
Consultant:	Renard S.A. PROFESSIONAL CONSULTING ENGINEERS
Contractor:	Xinjiang Beixin Road & Bridge Group Co., Ltd
Project:	Motorway (M-4) Package-11A Gofra-Jamini
Title:	AS BUILT DRAWING OF GENERATOR ROOM ROOF PLAN
Submitted:	Ref No. RSAM-47242077019

ABBREVIATION		
L.P	MEANS 0" ABOVE MIN. 50 MUD	
L.P1	MEANS 25" ABOVE MIN. 50 MUD	
L.P2	MEANS 50" ABOVE MIN. 50 MUD	


DETAIL-11

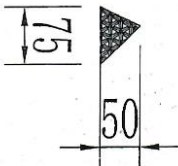



ROOF PLAN

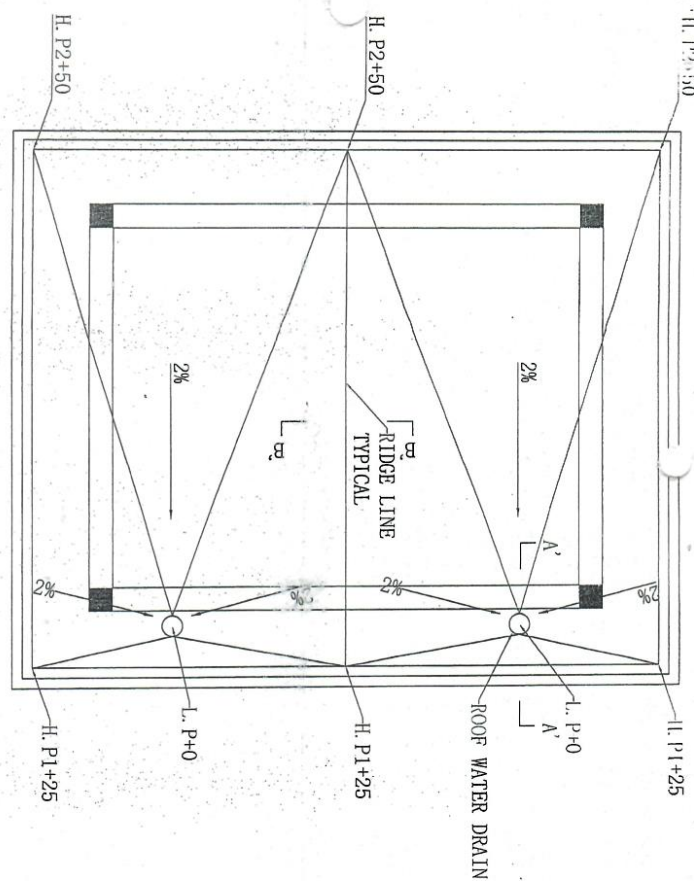

SECTION B'-B'

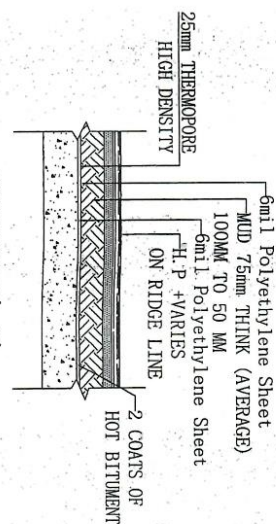



SECTION A'-A'

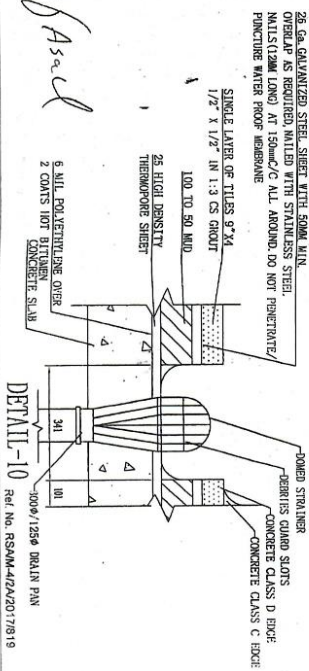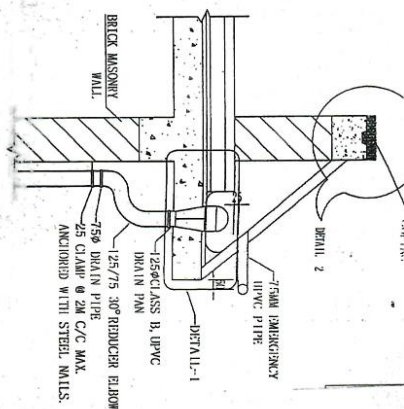

Client:	National Highway Authority Ministry of Communication	Consultant:	Renard S.A. PROGRES CONSULTING ENGINEERS	Contractor:	Xinjiang Beixin Road & Bridge Group Co., Ltd	Project:	Motorway (M-4) Package-11A Gofra-Jamini	Title:	AS BUILT DRAWING OF GENERATOR ROOM ROOF PLAN	Submitted:	Ref No. RSAM-47242077019
---------	---	-------------	---	-------------	---	----------	---	--------	---	------------	--------------------------

ABBREVIATION		
L.P	MEANS 0" ABOVE MIN. 50 MUD	
L.P1	MEANS 25" ABOVE MIN. 50 MUD	
L.P2	MEANS 50" ABOVE MIN. 50 MUD	


ROOF PLAN

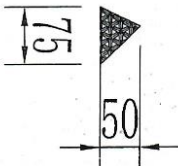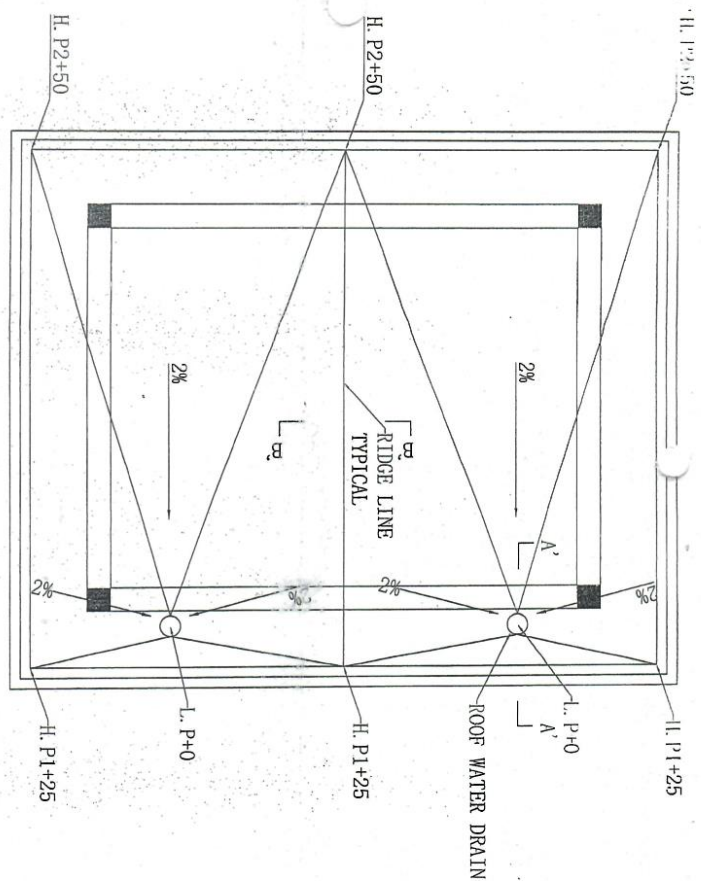



DETAIL-11

Kaf Asad

SECTION B'-B'

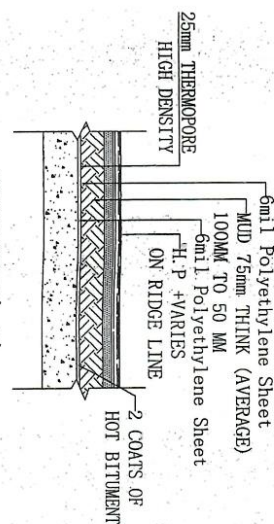



SECTION A'-A'

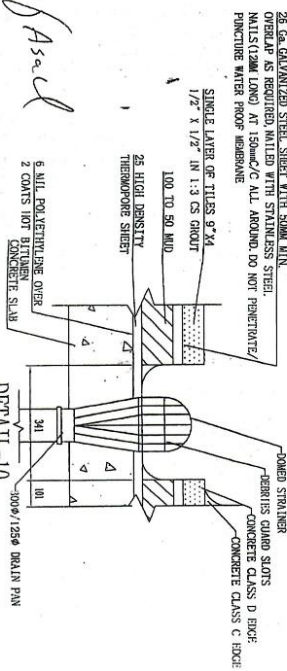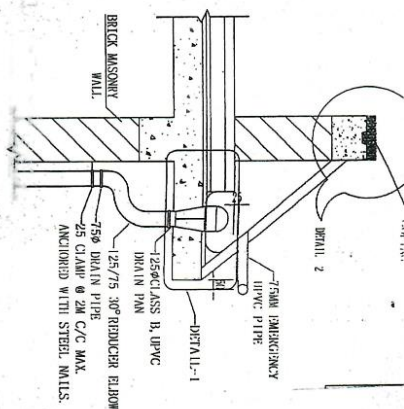


Client:	National Highway Authority Ministry of Communication	Consultant:	Renard S.A. INGENIEROS CONSULTORES	Contractor:	Xinjiang Beixin Road & Bridge Group Co., Ltd	Project:	Motorway (M-4) Package-11A Gajra-Jamuni	Title:	AS BUILT DRAWING OF GENERATOR PAD DETAIL (2500X1300) (3000X1524)	Submitted:		Approved:	
For 500/20KVA		For 100KVA											

GENERATOR FOUNDATION PLAN

GENERATOR FOUNDATION PLAN For 100KVA

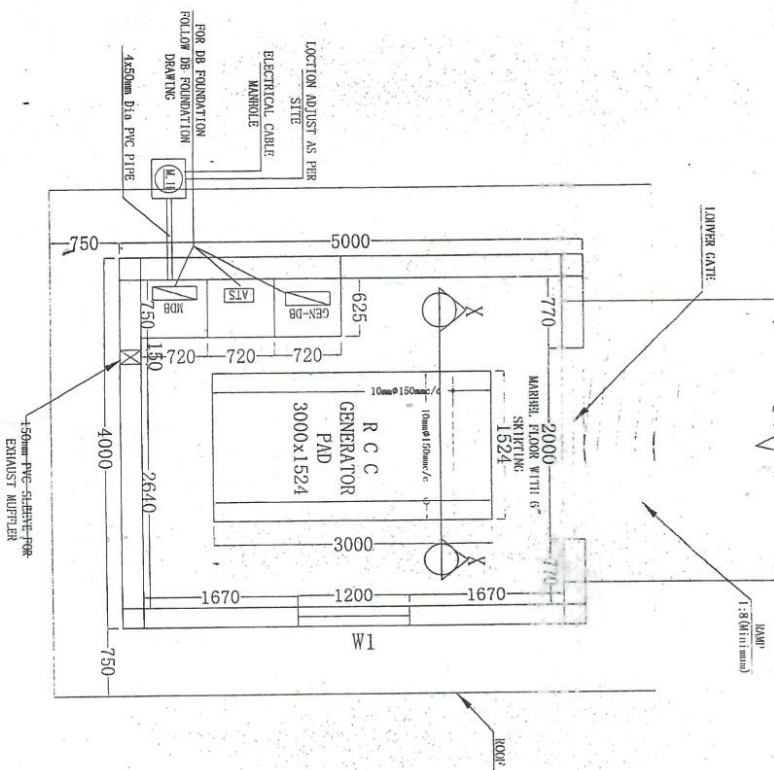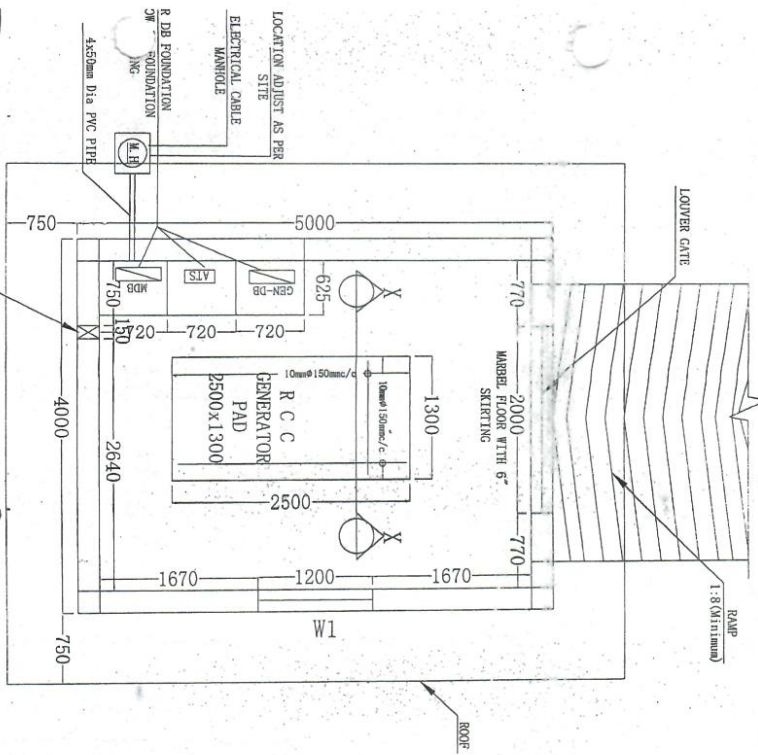

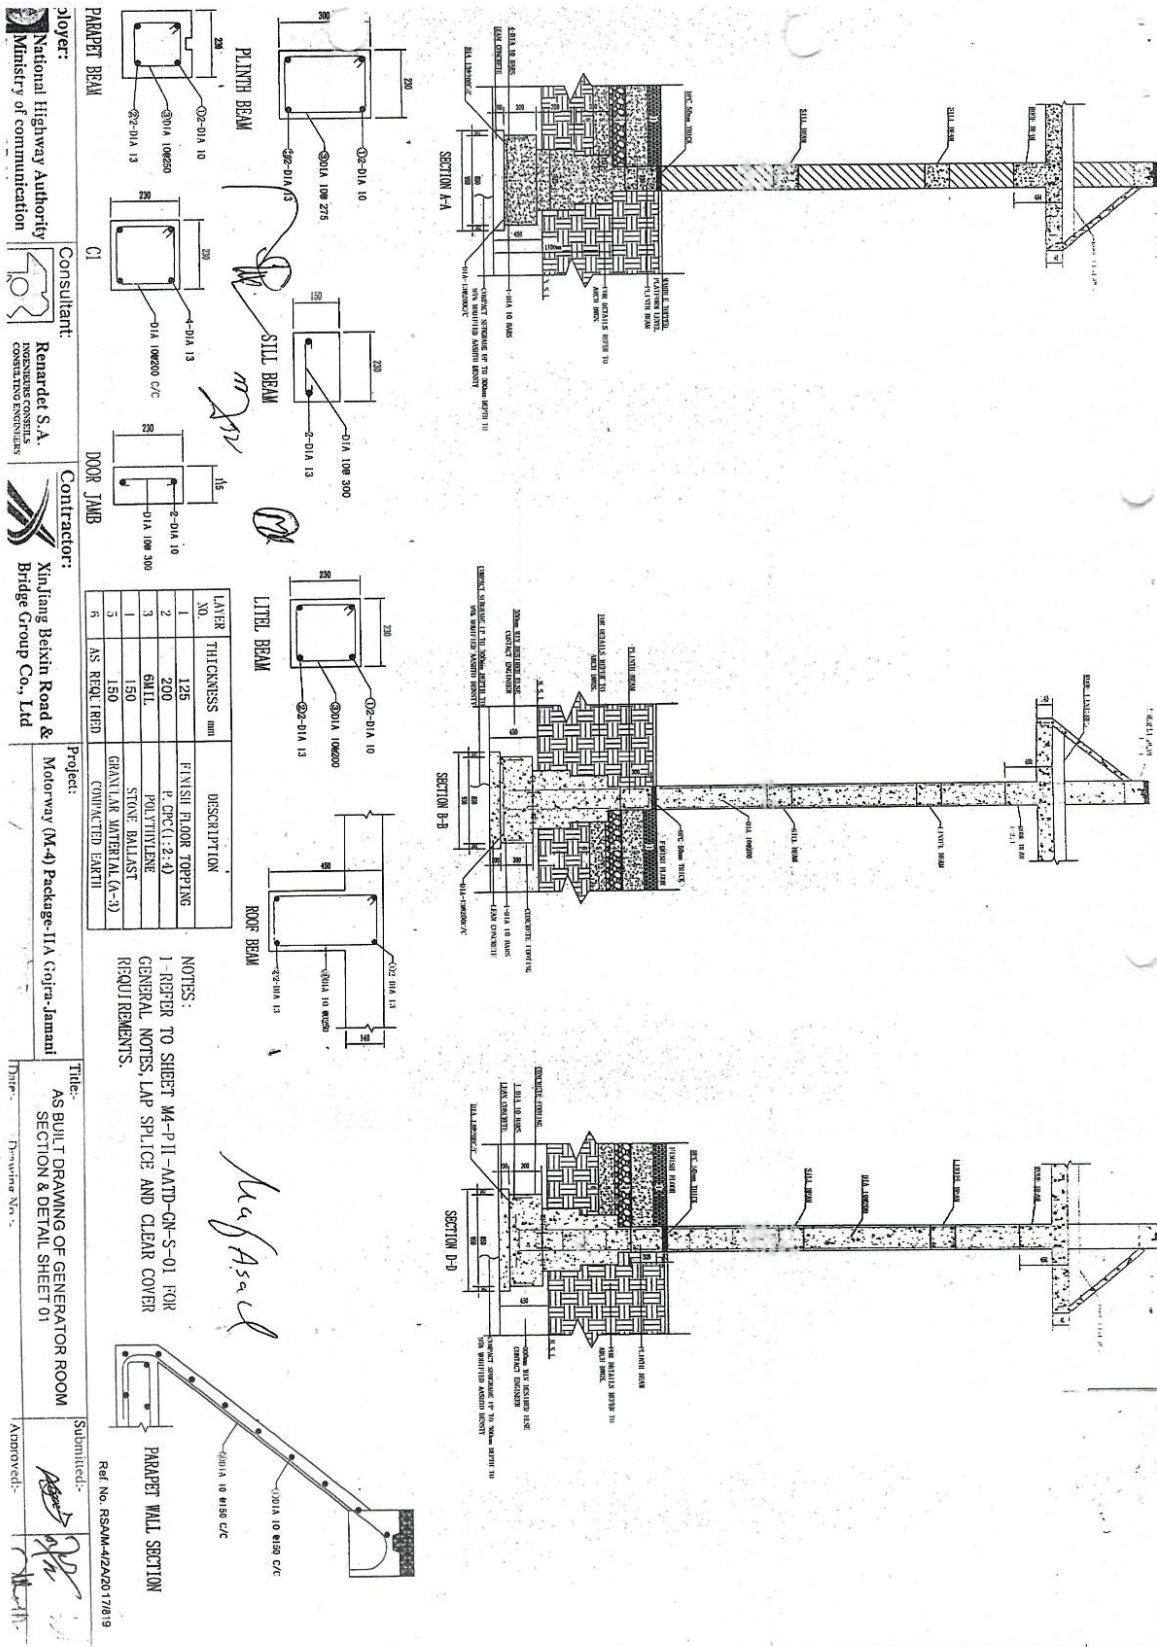



Owner: National Highway Authority Ministry of Communication Government of Pakistan	Consultant:  Renardet S.A. ENGINEERS/CONSULTANTS CONSULTING ENGINEERS	Contractor:  Xinjiang Beixin Road & Bridge Group Co., Ltd	Project: Motorway (M-4) Package-IIA Gofra-Jamali	Title: AS BUILT DRAWING OF GENERATOR ROOM SECTION & DETAIL SHEET 02	Submitted:  Approved:
--	---	---	--	--	---

LAYER NO.	THICKNESS mm	DESCRIPTION
1	125	FINISH FLOOR TOPPING
2	200	P.C.P.C (1:2:4)
3	60ML	POLYETHYLENE
4	150	STONE BALLAST
5	150	GRAVEL MATERIAL (A.3)
6	AS REQUIRED	COMPACTED EARTH

NOTES:
 1- REFER TO SHEET M4-P-II-AATD-GN-S-01 FOR
 GENERAL NOTES, LAP SPLICE AND CLEAR COVER
 REQUIREMENTS.

Asif Asad

Ref. No. RSAM/42A/2017/819

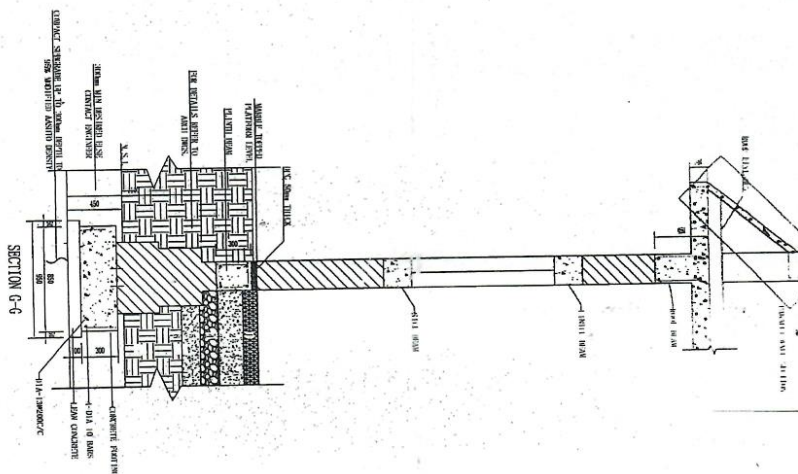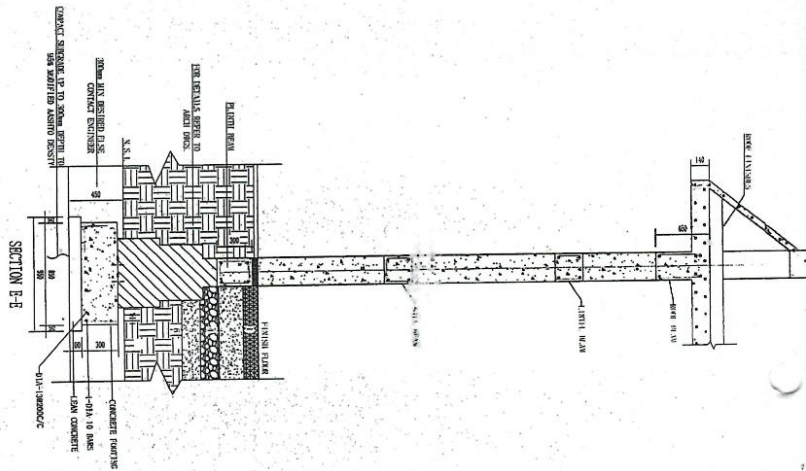



Client:
National Highway Authority
Ministry of communication


Consultant:
Renardel S.A.
CONSULTING ENGINEERS
CONSTRUCTION DIVISION

Contractor:
Xinjiang Beixin Road &
Bridge Group Co., Ltd


Project:
Motorway (M-4) Package IIA Gd/r-jamani

Title:
AS BUILT DRAWING OF
WEIGHT BRIDGE CONTROL ROOM AT RAMP 2 &
FLOOR PLAN, LEFT & RIGHT ELEVATION

Submitted:
Ref. No. RSAM-4/2A/2017/619

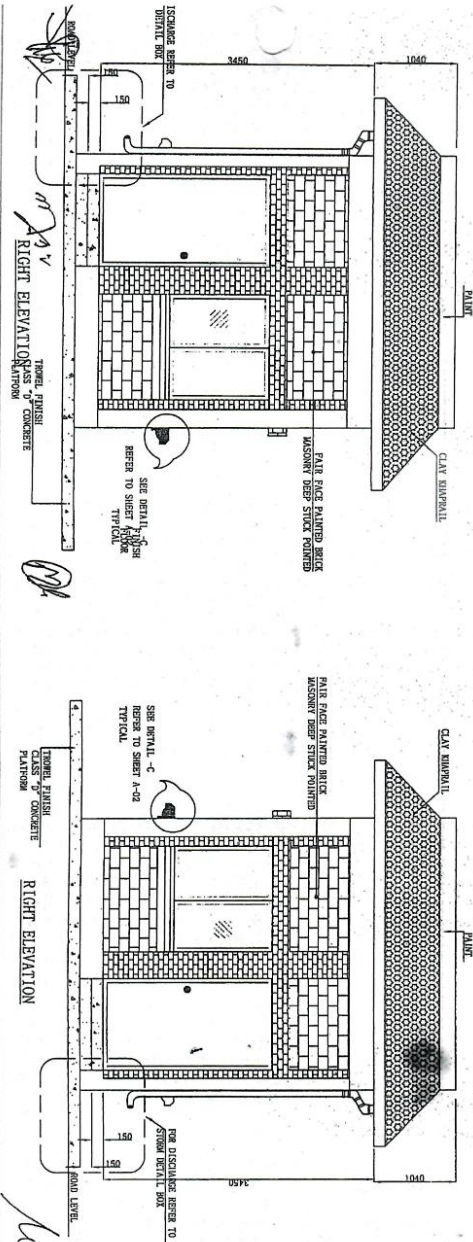

CONTROL ROOM PLAN

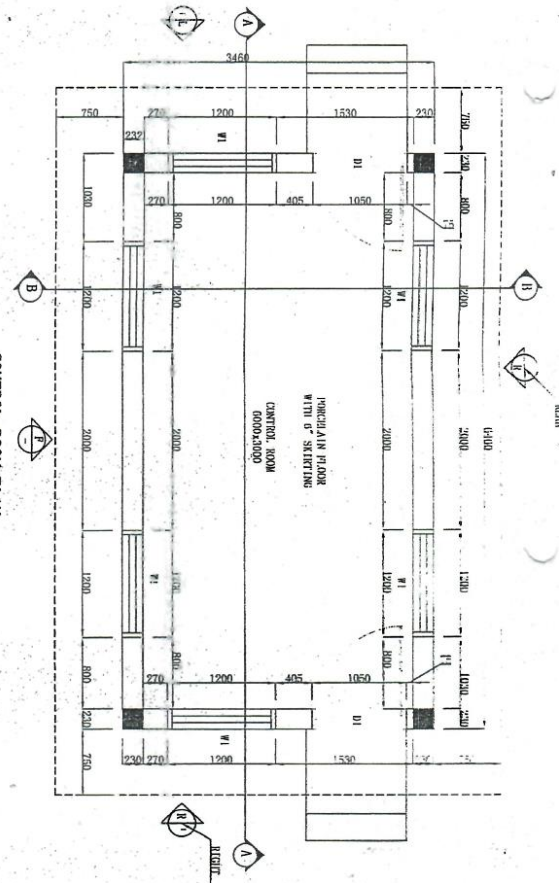

SCHEDULE OF DOOR & WINDOW			
S No.	TYPE	SIZE (mm)	NO
1	D1	1050X2150	2
2	W1	1200X1250	6

Client:
National Highway Authority
Ministry of communication

Consultant:
Renardet S.A.
INGENIEURS CONSULTANTS
CONSULTING ENGINEERS


Contractor:
Xinjiang Beixin Road &
Bridge Group Co., Ltd

Project:
Motorway (M-4) Package-IIA Corridor Janam


Title:
AS BUILT DRAWING OF
CENTRAL ROOM AT RAMP 2 & 4
FRONT & REAR ELEVATION

Submitted:
Ref No. RSAM/4242017/19


DETAIL - C

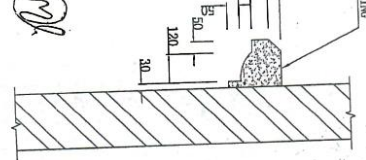


DETAIL - D

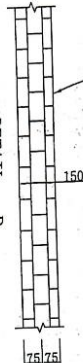


DETAIL - E

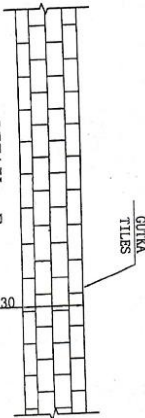

DETAIL - F

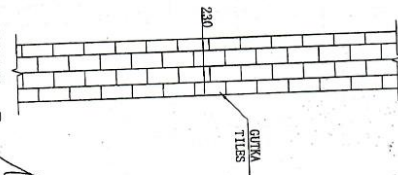

FRONT ELEVATION

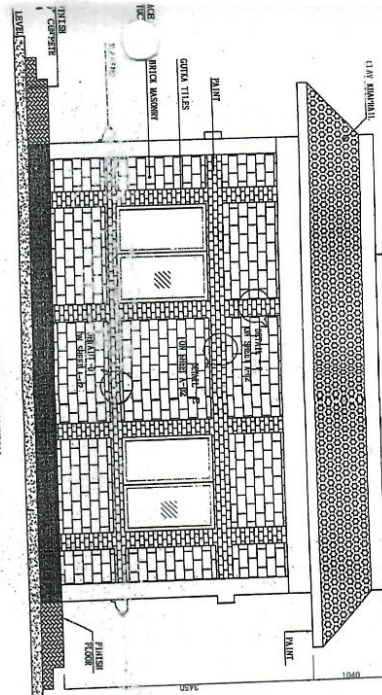

FRONT ELEVATION

