

Client: National Highway Authority
Ministry of communication

Consultant: Raurdet S.A.
INGENIERIE CONSULTANT
PONTONS ET TRAVAUX




Contractor: Xinjiang Beixin Road & Bridge Group Co., Ltd


Project: Motorway (M-4) Package-11A (Cofa-Jamani)


Title: AS BUILT DRAWING OF WEIGHT BRIDGE CONTROL ROOM AT RAMP 2 & 4 SECTION 82 DETAIL


Submitted: [Signature]
Approved: [Signature]

Ref. No. RSAM-4/2A/2017/19

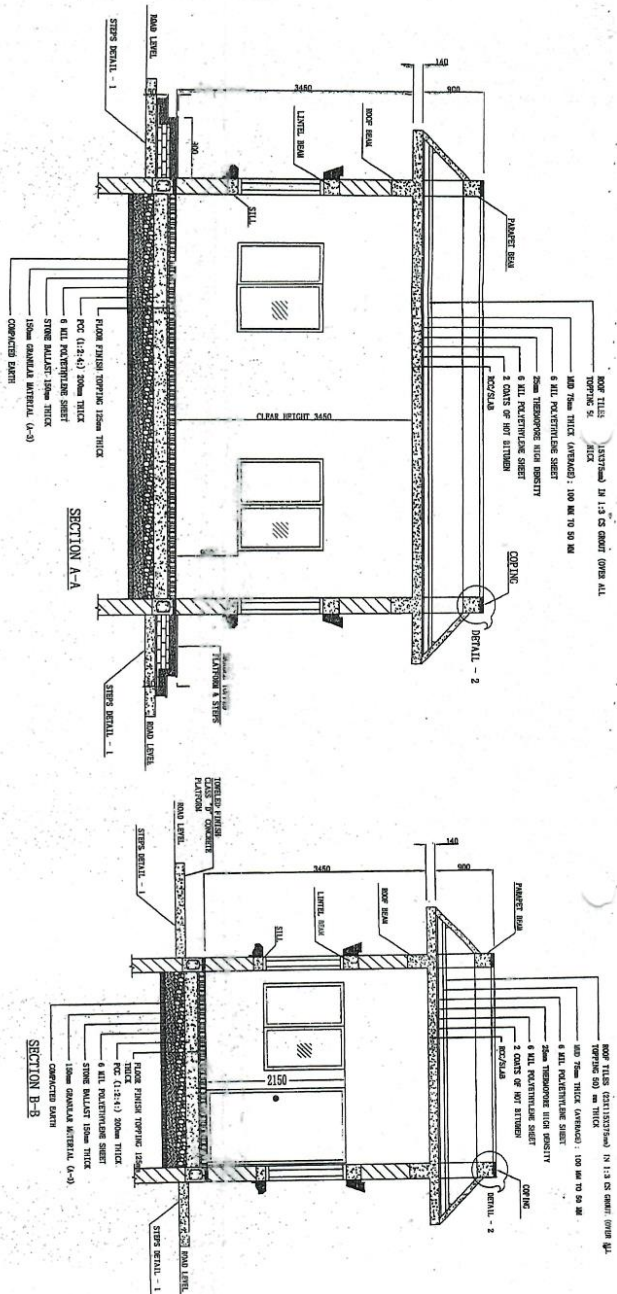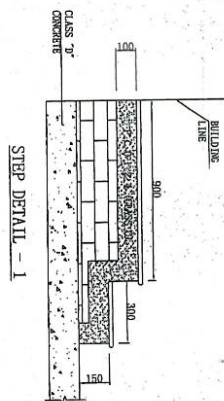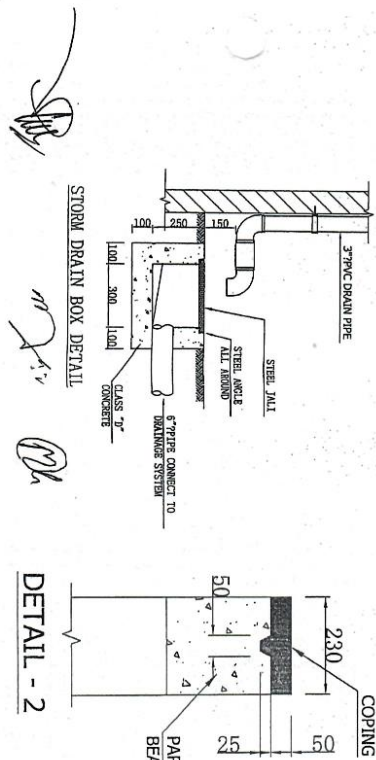


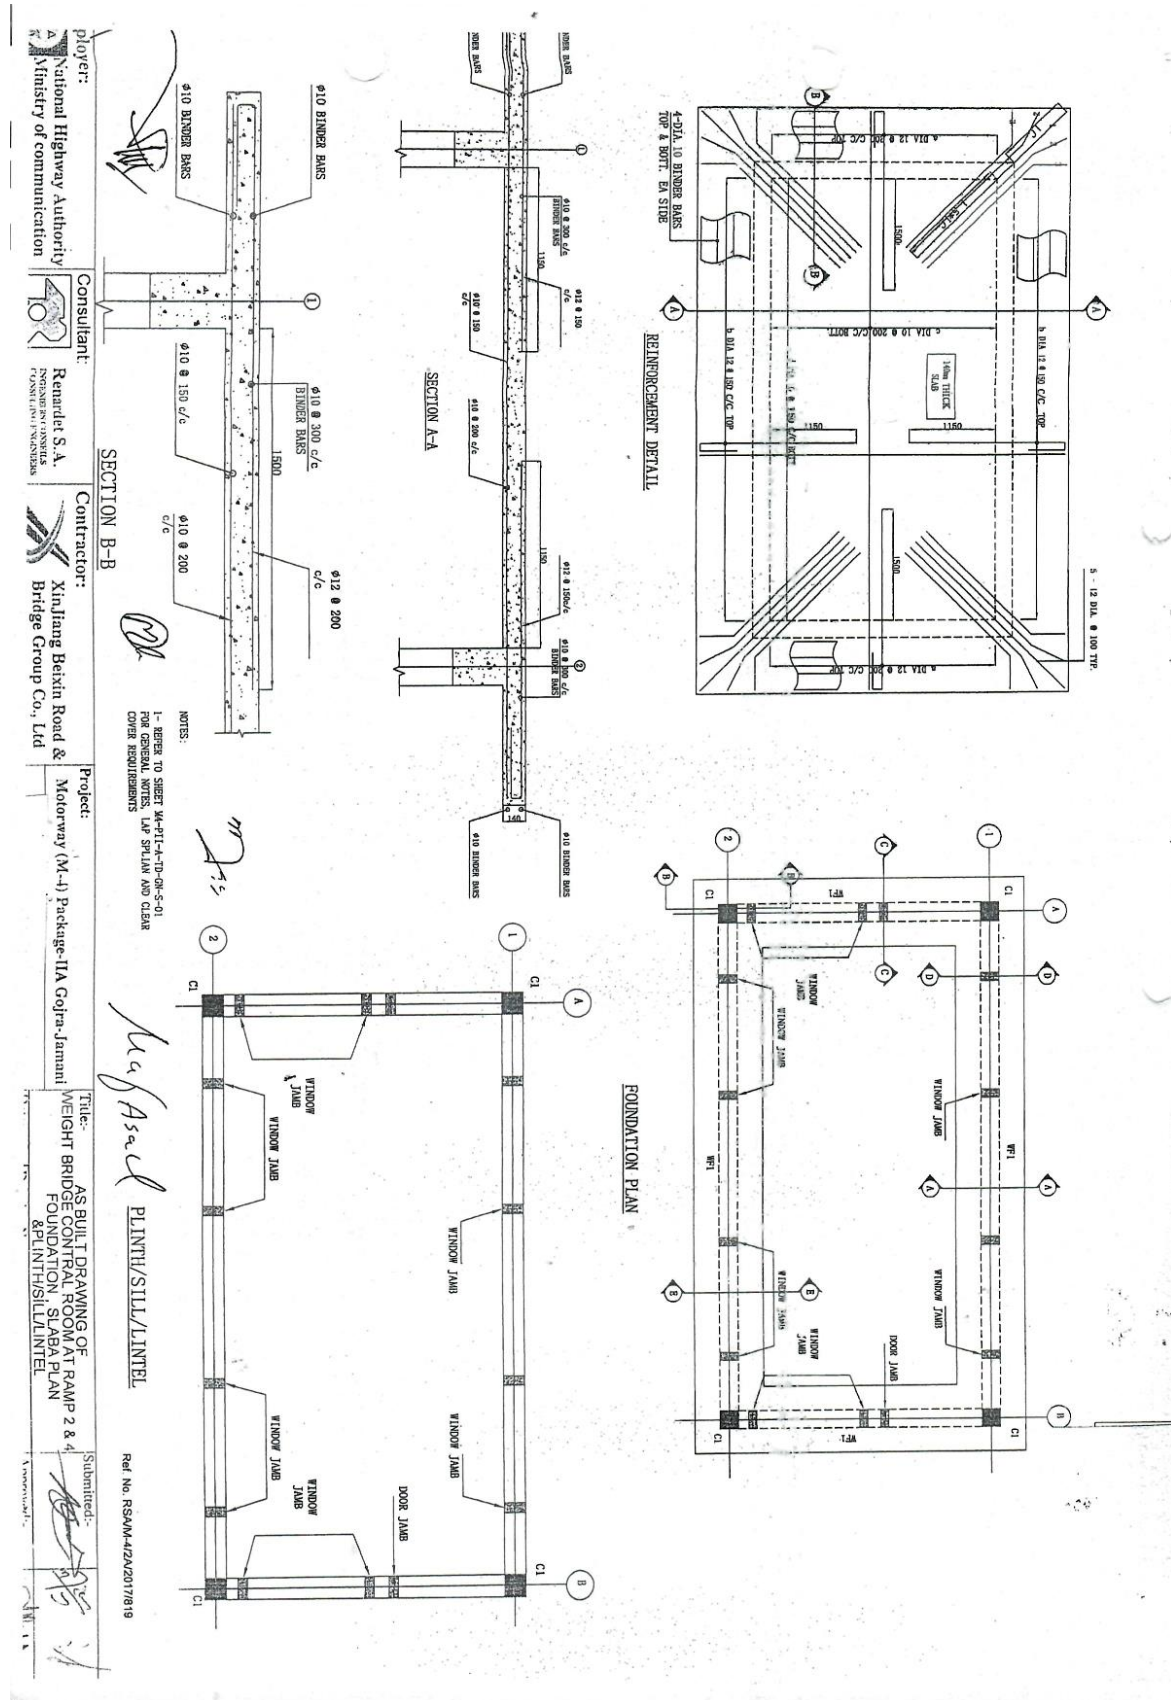

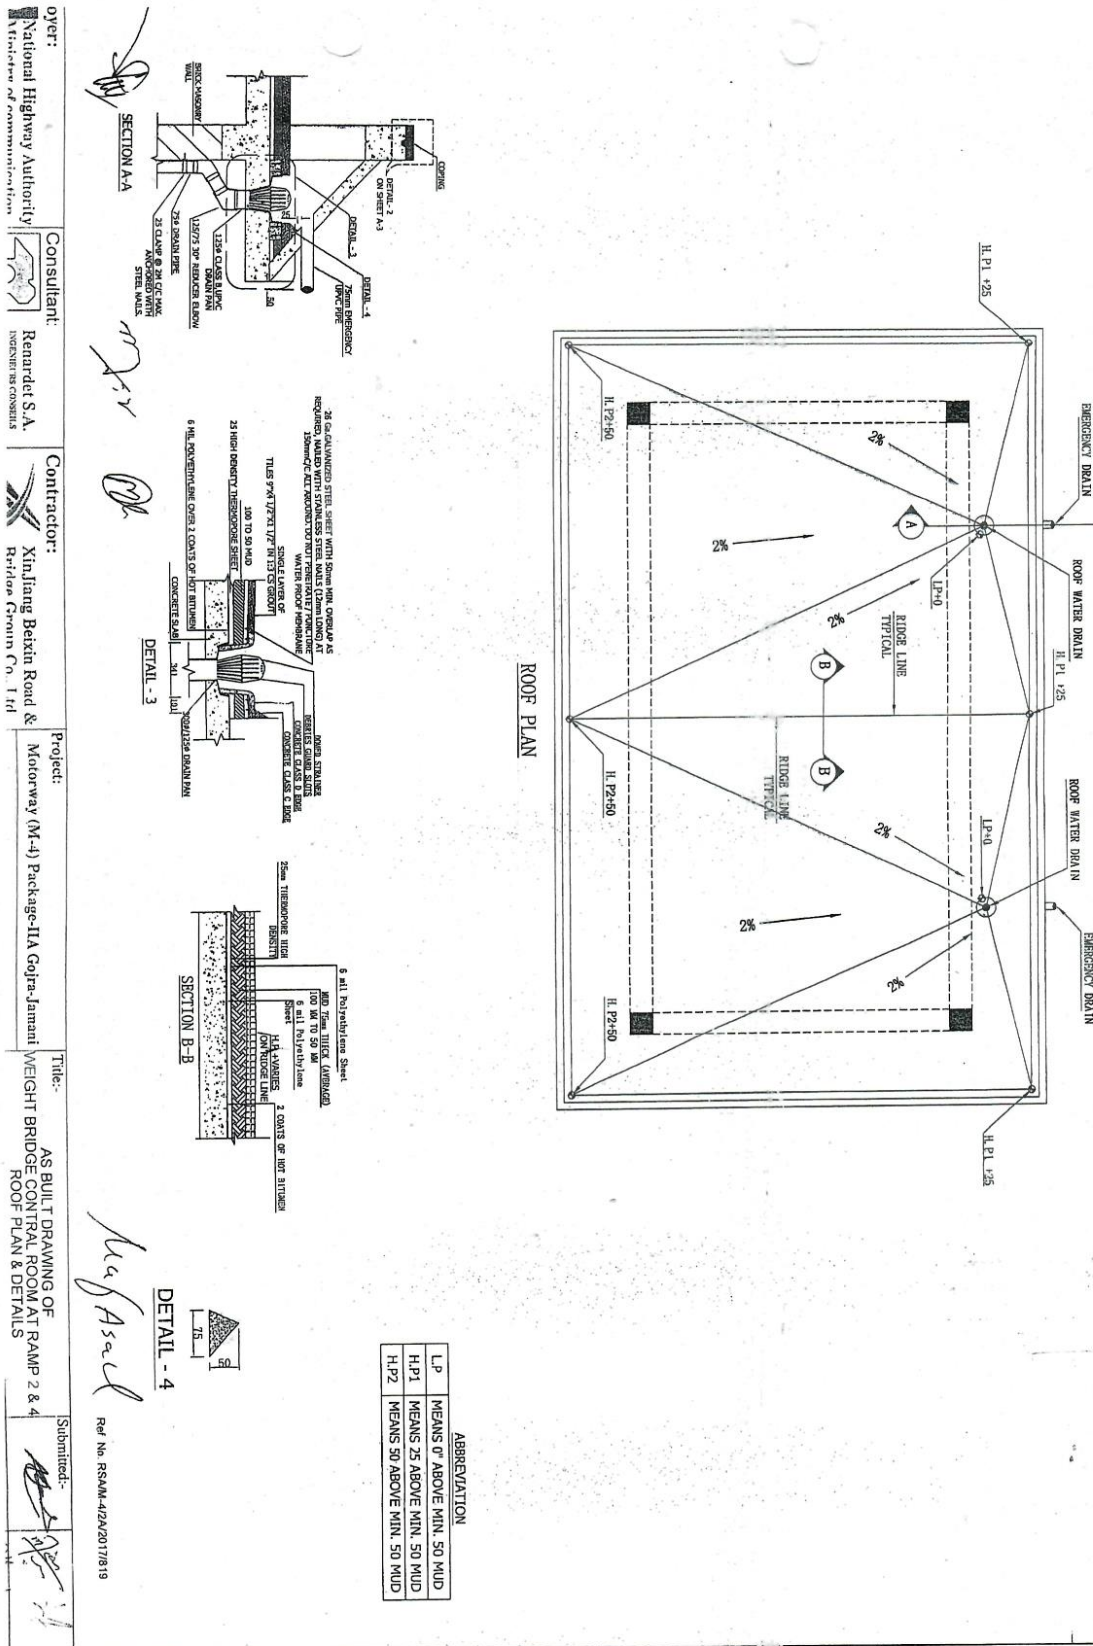

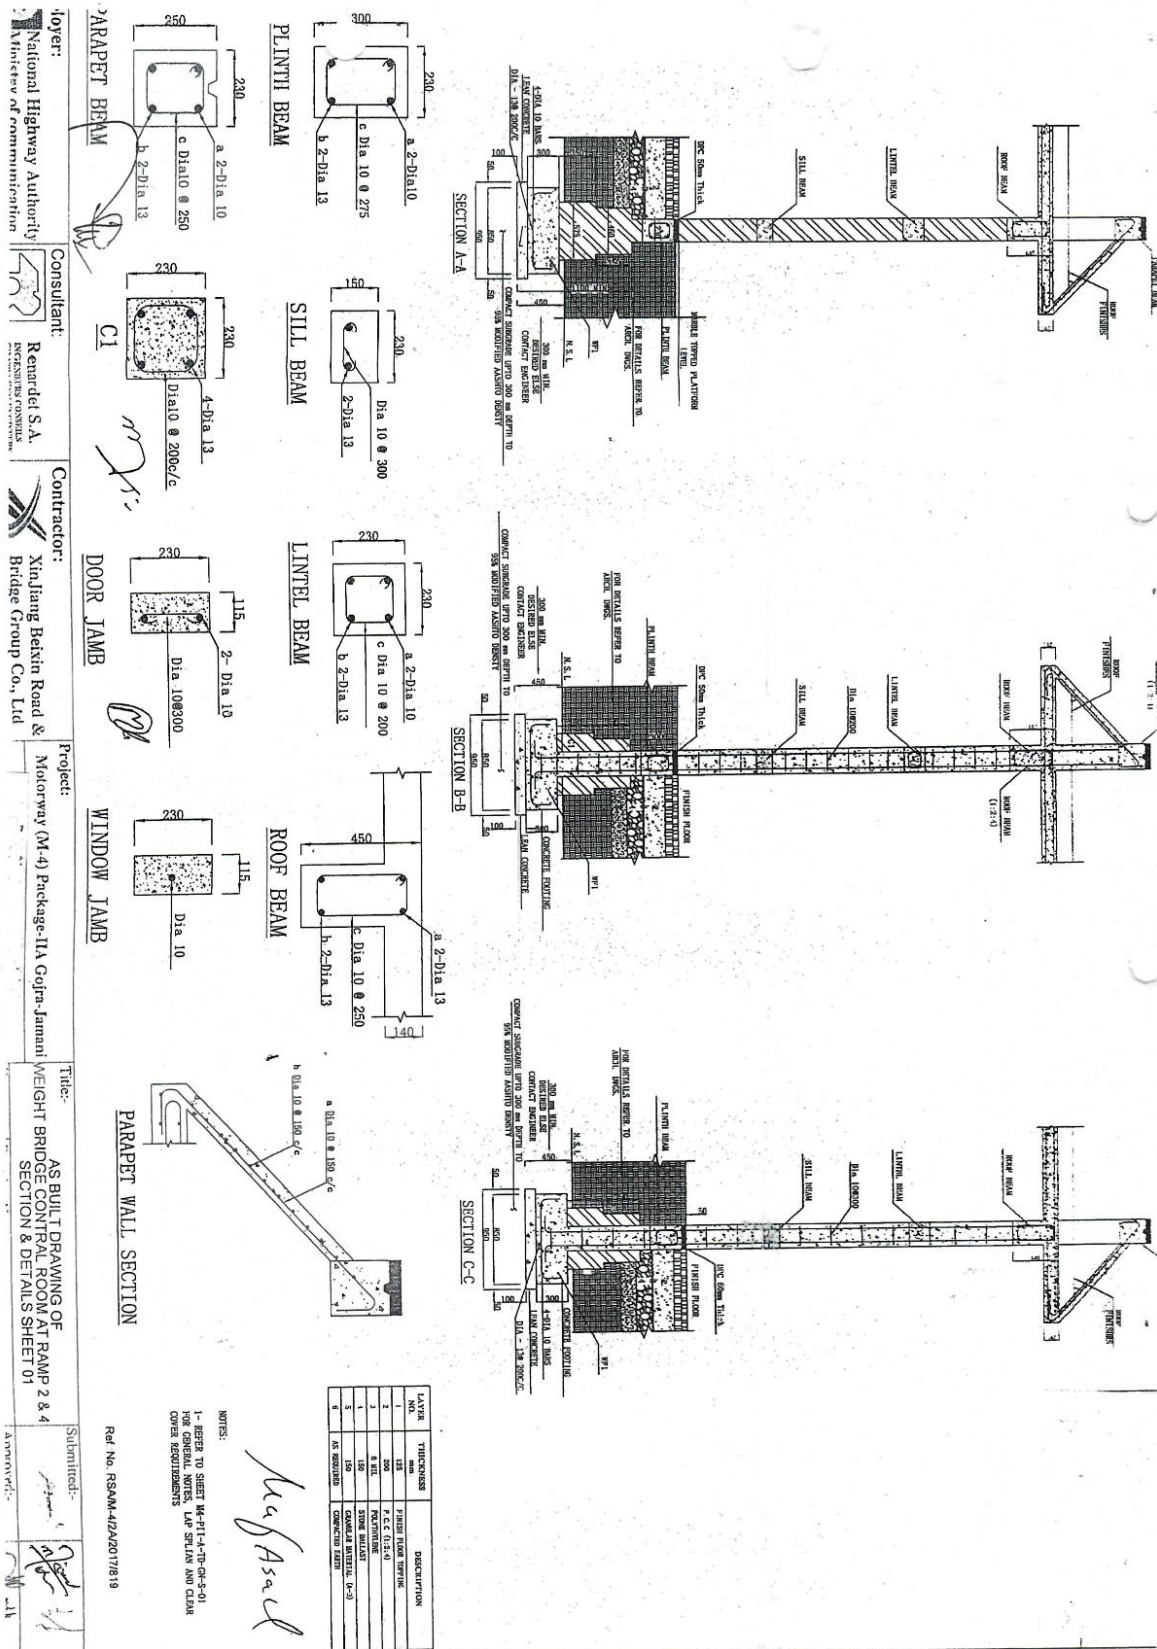



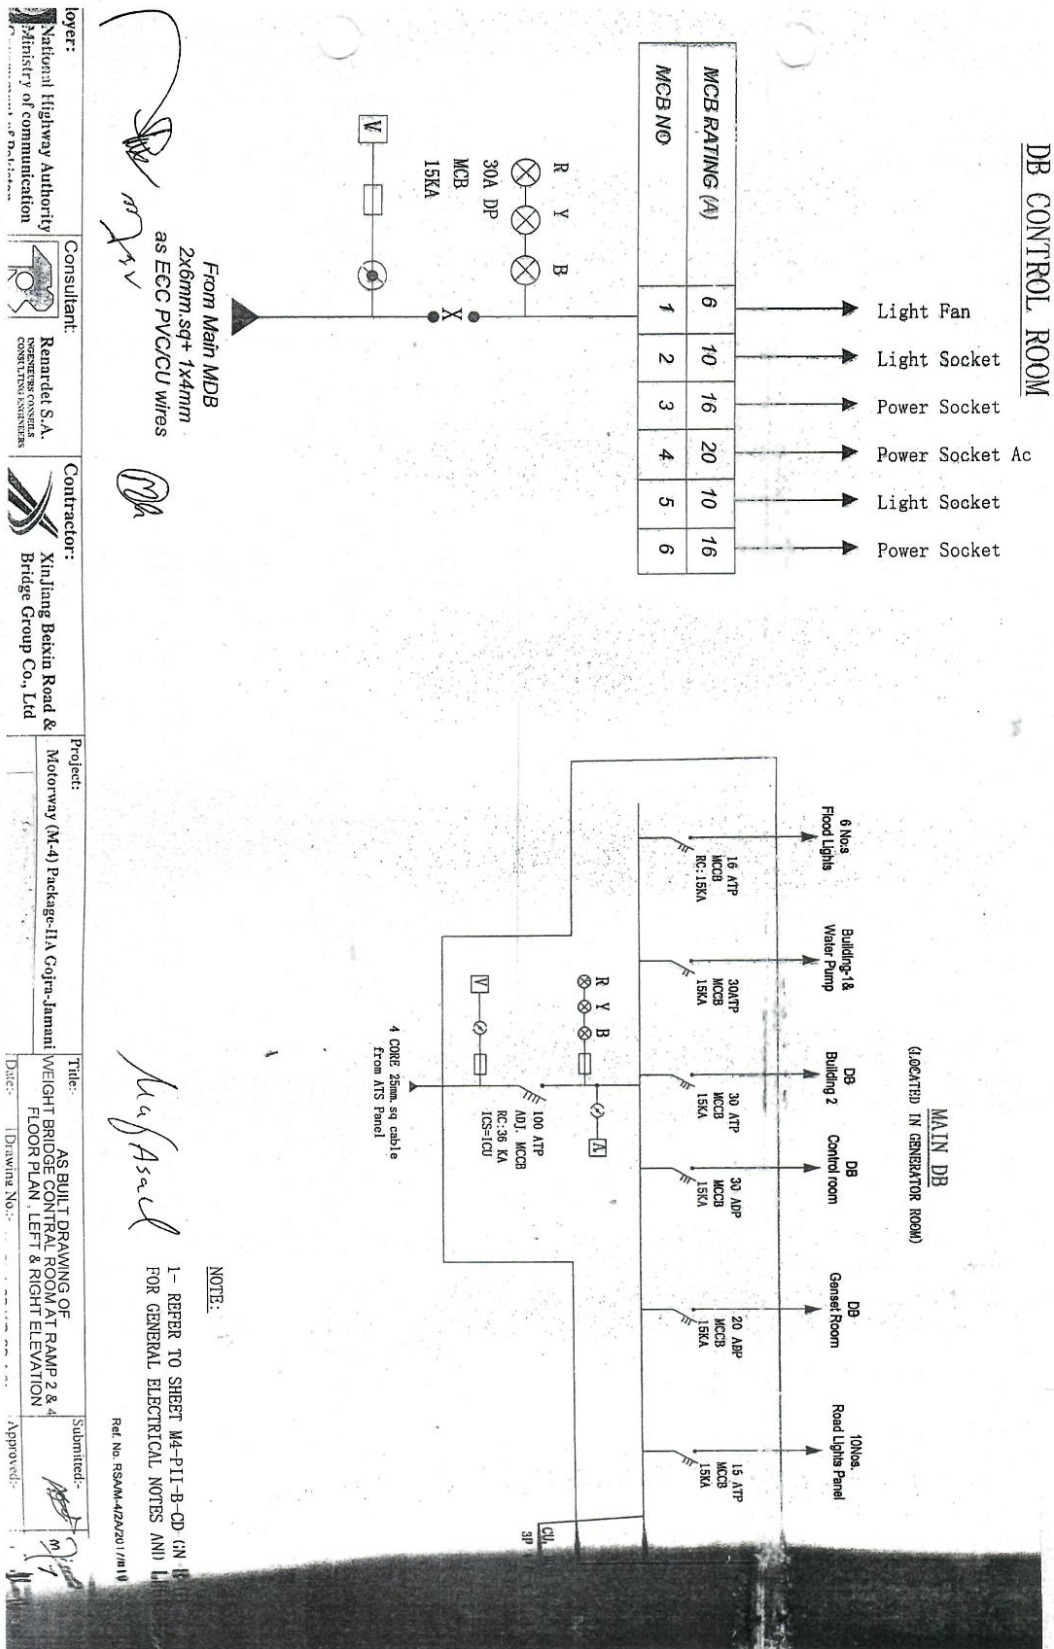

Client:
National Highway Authority
Ministry of Communication
Government of Pakistan

Consultant:
Remedel S.A.
CONSULTING ENGINEERS


Contractor:
Xinjiang Baixin Road &
Bridge Group Co., Ltd


Project:
Motorway (M-4) Package-1/A Gajra-Jamali

Title:
AS BUILT DRAWING OF OFFICE BUILDING
PLAN


Submitted:
Approved:
Date: 12/01/2019
Drawing No.: WA-P.H.A.-D-MB-GA-A-01


SCHEDULE OF DOOR & WINDOW		
No.	TYPE	SIZE (mm)
D-1	1650X2150	2
D-2	900X2150	2
D-3	750X2150	2
W-1	1200X1230	4
V-1	950X1550	3
V-2	600X1550	2

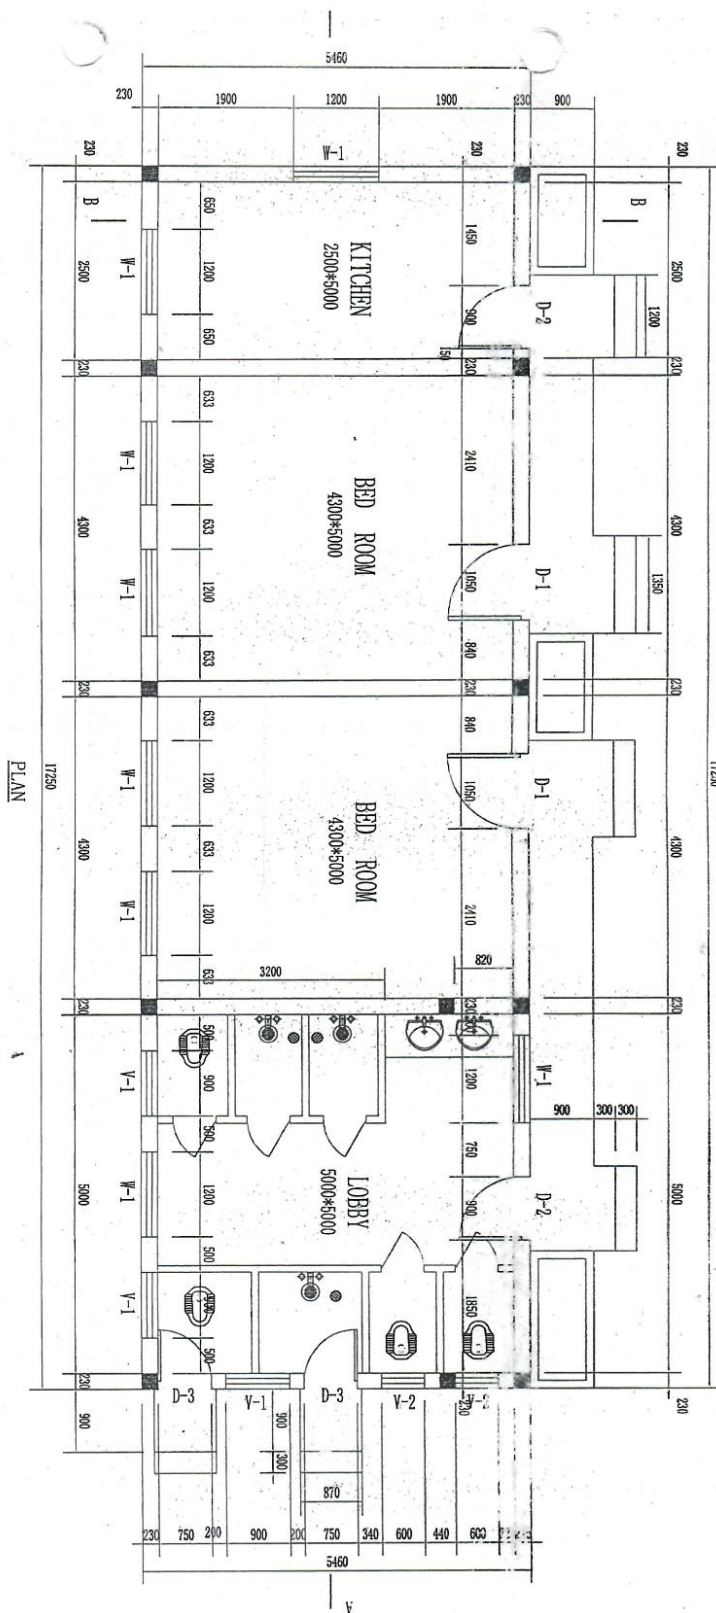

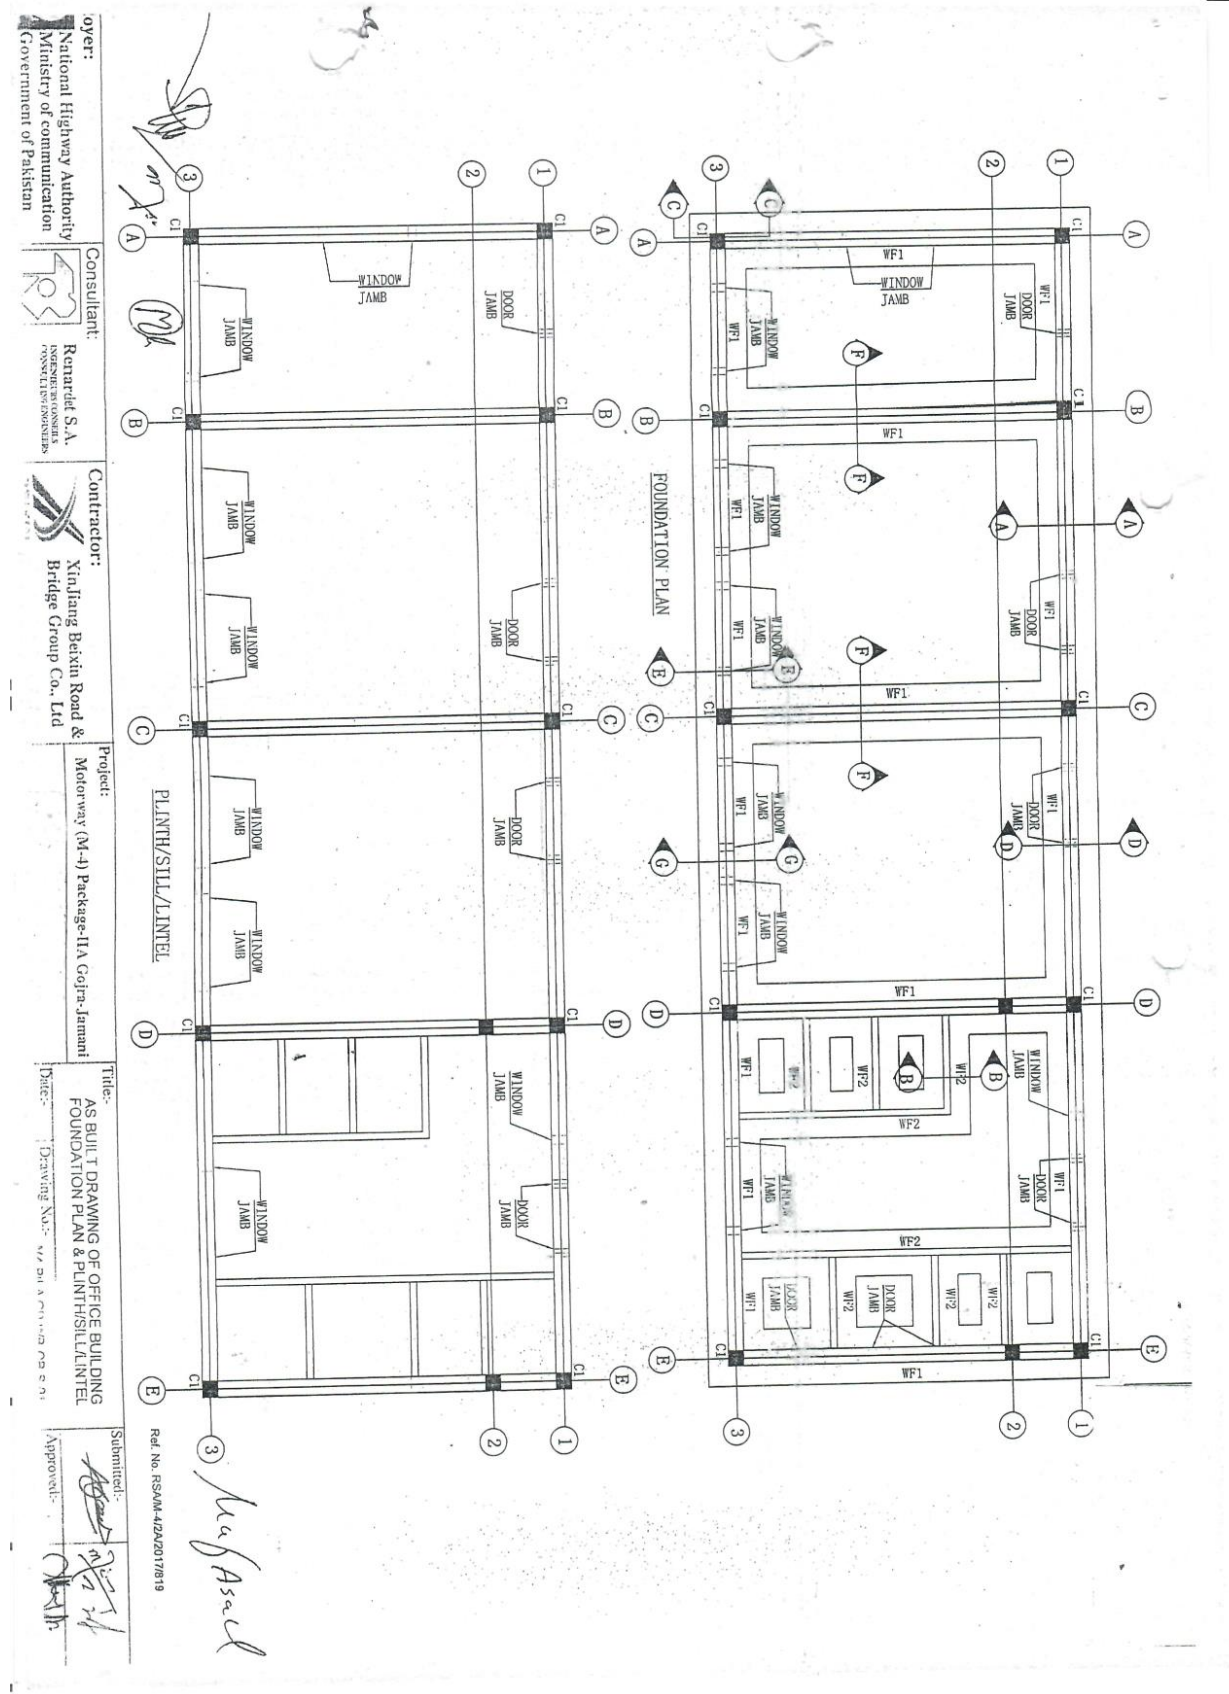

10

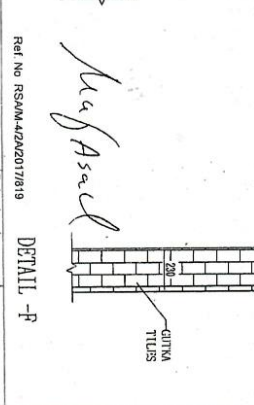

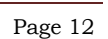

Client:	National Highway Authority Ministry of Communication Government of Pakistan	Consultant:	Renardet S.A. INGENIEUR-CONSEILS CONSTRUCTION	Contractor:	Xinjiang Baixin Road & Bridge Group Co., Ltd	Project:	Motorway (M-4) Package-IIA Cojra-Jamali	Title:	AS BUILT DRAWING OF OFFICE BUILDING SLAB & SECTIONS	Submitted:	Approved:
Date:	01-06-2019	Drawing No:	M4-P11-A-CD-WB-03-S-02	Ref. No.	RSMM-42A/2017/819						

