

Rel. No. RSAM-4/2A2017/819

Client:
National Highway Authority
Ministry of communication

Consultant:
Remarcel S.A.
PROFESSIONAL CONSULTANT
COMMUNICATIONS

Contractor:
Xinjiang Beixin Road &
Bridge Group Co., Ltd

Project:
Motorway (M-4) Package-IIA Gogra-Jamali

Title:
AS BUILT DRAWING OF ACCOMMODATION BUILDING
LIGHTING & POWER LAYOUT PLAN

Date:
Drawing No.:
Ref. No. RSAM-4242017/19

Submitted:-

Approved:-

Ref. No. RSAM-4242017/19

Ref. No. RSAM-4242017/19

LIGHTING LAYOUT PLAN ACCOMMODATION BUILDING


NOTES:

1-REFER TO SHEET M4-P11-AATD-CN-E-FOR
ELECTRICAL NOTES.


2-REFER TO SHEETS M4-P11-AATD-CN-E-01 OR 02
LIGHTING PROTECTION & GROUNDING DETAILS.


Ref. No. RSAM-4242017/19

Ref. No. RSAM-4242017/19

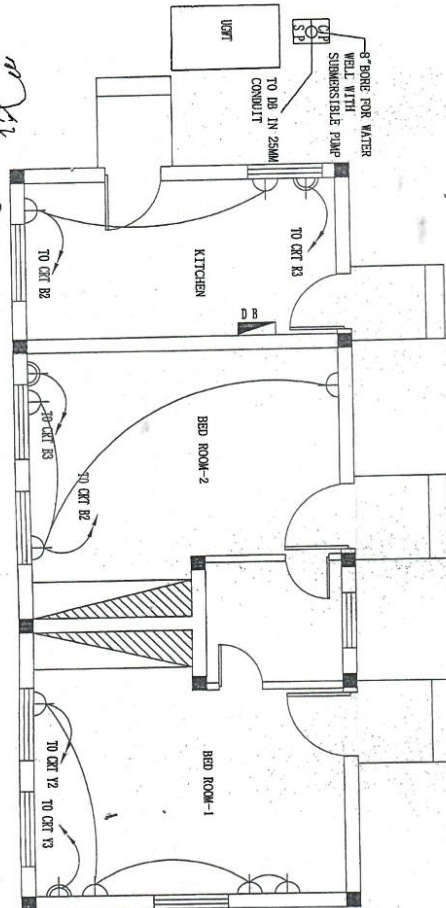

LIGHTING LAYOUT PLAN ACCOMMODATION BUILDING

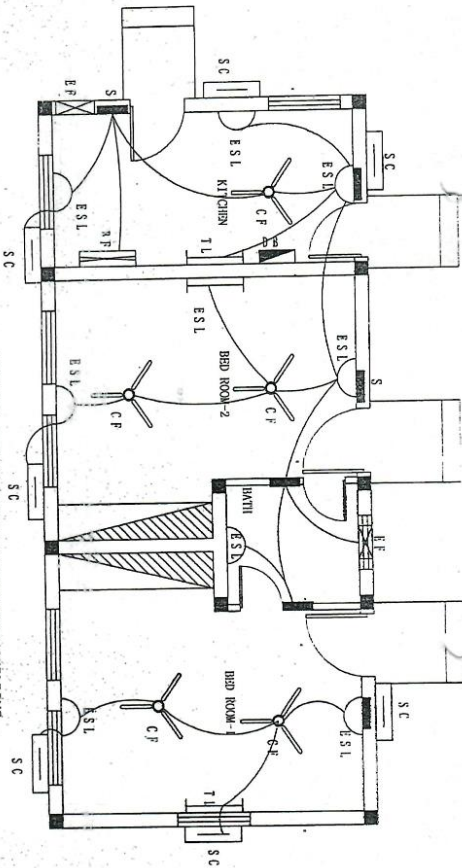

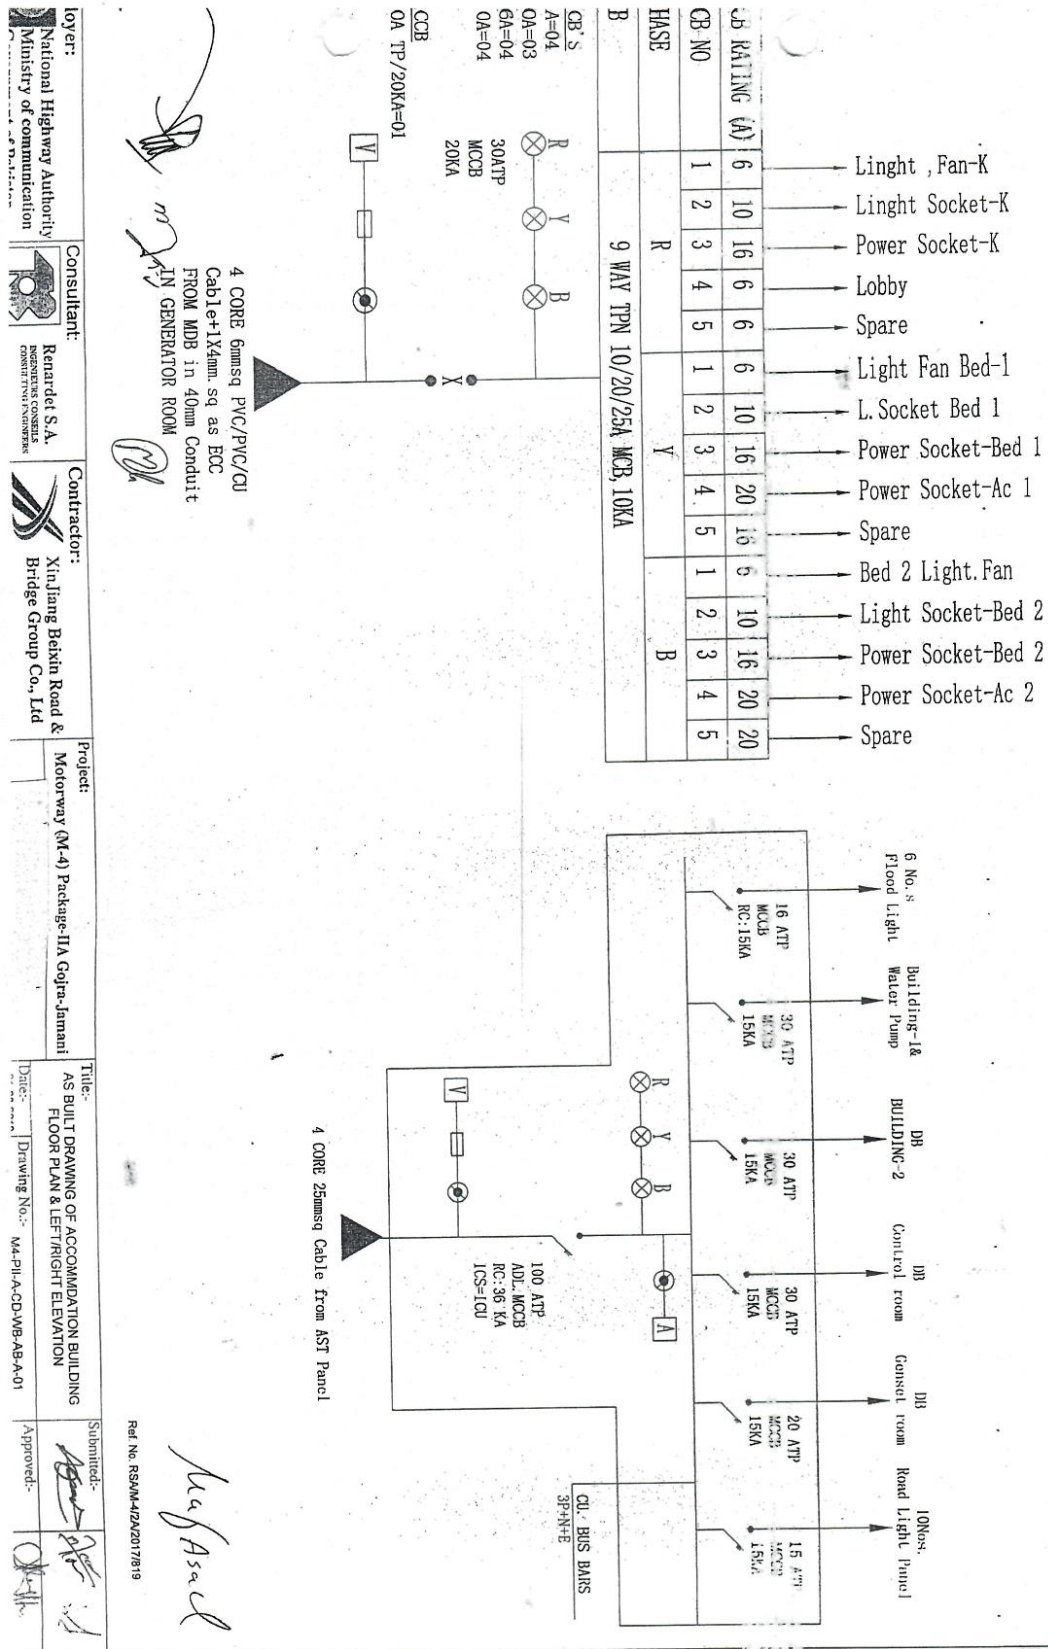

NATIONAL HIGHWAY AUTHORITY
MINISTRY OF COMMUNICATIONS
GOVERNMENT OF PAKISTAN



Contractor:
Xinjiang Baixin Road &
Bridge Group Co., Ltd

Project:
Motorway (M-4) Package-IIA Gofra-Jamrud

Title:
AS BUILT DRAWING OF
RAINFALL WEIGHT BRIDGE
RCC LINK ROAD


Date:
11.10.2019

Submittal:
APPROVED


Handwritten signature

Handwritten signature


TRANSVERSE JOINT
SEE DETAIL-3

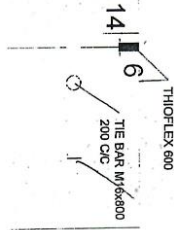


EXPANSION JOINT
SEE DETAIL-2

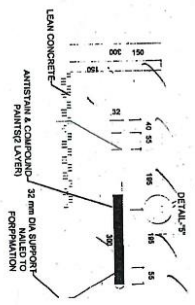

CONTRACTION JOINT
SEE DETAIL-1

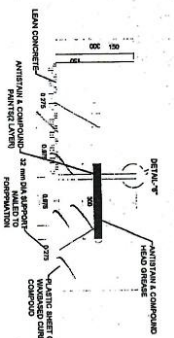

CONTRACTION JOINT
SEE DETAIL-1

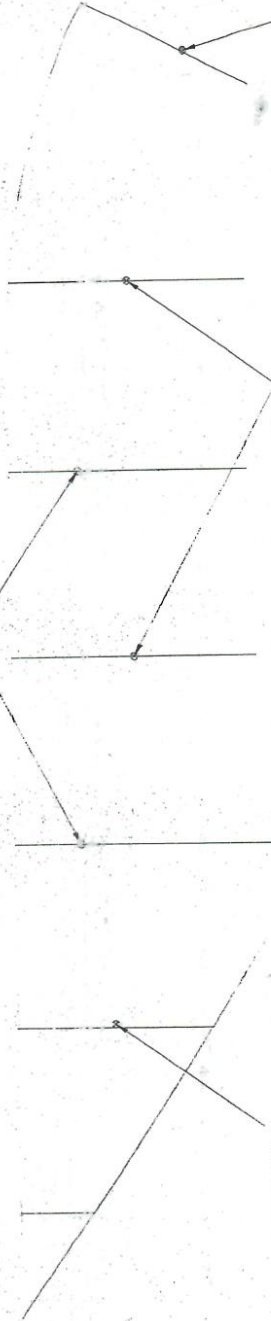

TRANSVERSE JOINT
SEE DETAIL-3

EXPANSION JOINT
SEE DETAIL-2

EXPANSION JOINT
SEE DETAIL-2



ATONAL HIGHWAY AUTHORITY
MINISTRY OF COMMUNICATIONS
GOVERNMENT OF PAKISTAN



CONTRACTOR:
Xinjiang Bekin Road &
Bridge Group Co., Ltd

DATE:
RECOMMENDED
C/E, /E.S.

FAISALABAD-MULTAN MOTORWAY (M-4)
GOHRA-SHORROT SECTION
(PACKAGE-II)

AS BUILT DRAWING
WEIGHT BRIDGE PLAN OF
RAMP 1&2


SUBMITTED-
APPROVED-
DATE

Handwritten signature

Handwritten signature

Handwritten signature

Handwritten signature: Asif Asad

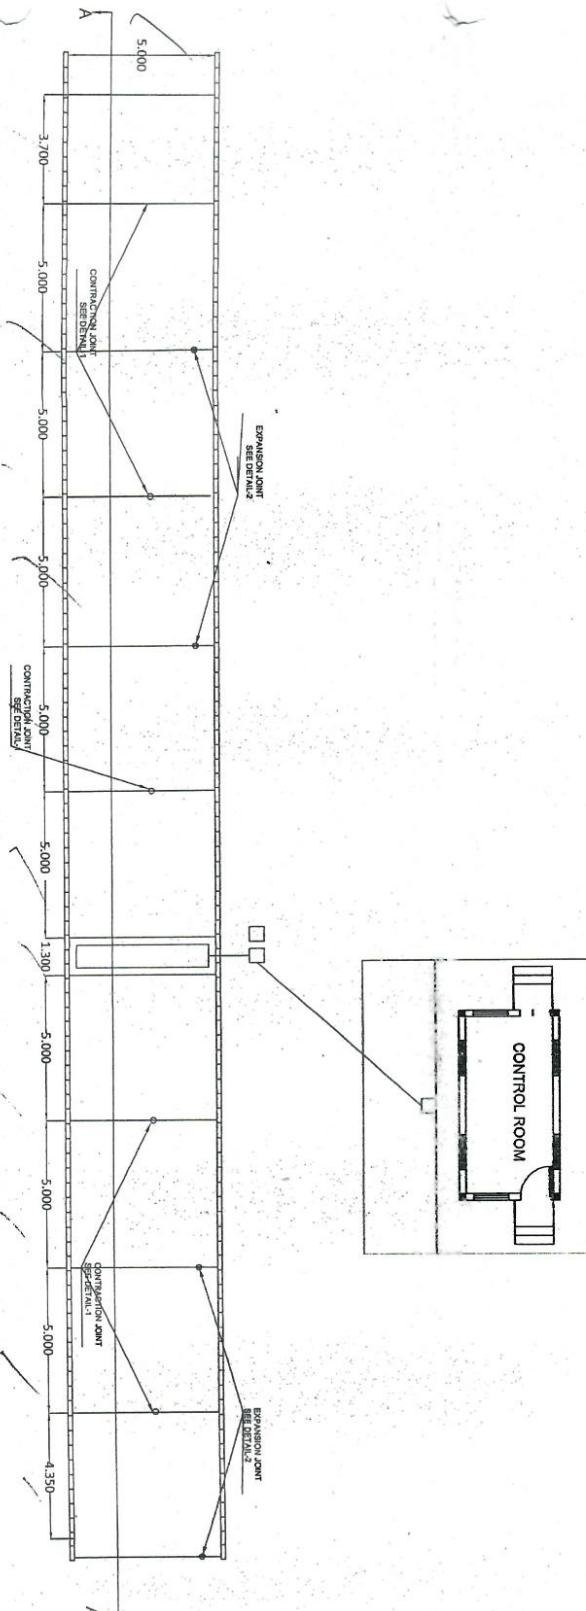



NATIONAL HIGHWAY AUTHORITY
MINISTRY OF COMMUNICATIONS

RENARDET
CONSULTING ENGINEERS
Geneve - Switzerland

Contractor:
Xinjiang Beixin Road & Bridge Group Co., Ltd

FAISALABAD-AQUITAN MOTORWAY (M4)
GOORA - SHORT CUT SECTION
(PACKAGE-II)

DATE: _____
DRAWING No. _____

AS BUILT DRAWING OF
STEEL DETAIL OF
WEIGHT BRIDGE

SUBMITTED: _____
APPROVED: _____

DATE: _____
DRAWING No. _____


AS BUILT DRAWING OF
STEEL DETAIL OF
WEIGHT BRIDGE

Handwritten signature

Handwritten signature

Handwritten signature

Handwritten signature

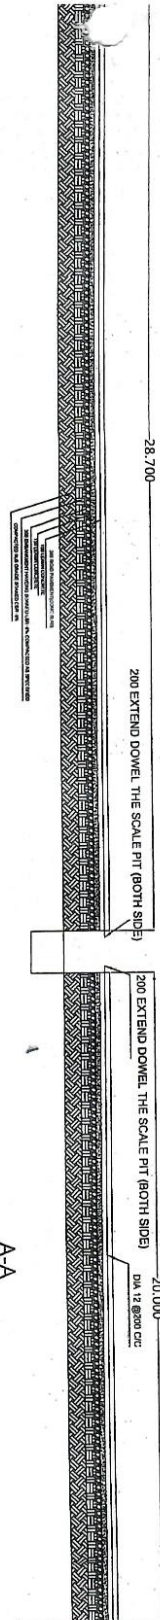

TOP ELEVATION

