

Client:
National Highway Authority
Ministry of Communication
Government of Pakistan

Consultant:
Remarried S.A.
SARAJI & ASSOCIATES
PUNJAB, INDIA





Contractor:
Xinjiang Beishan Road &
Bridge Group Co., Ltd


Project:
Motorway (M-4) Package IIA Gofra-Jamrud

Title:
AS BUILT DRAWING OF GENERATOR ROOM
FLOOR PLAN, SECTION & ELEVATION

Submitted:
Ref No RS444/2017/8/9

Approved:

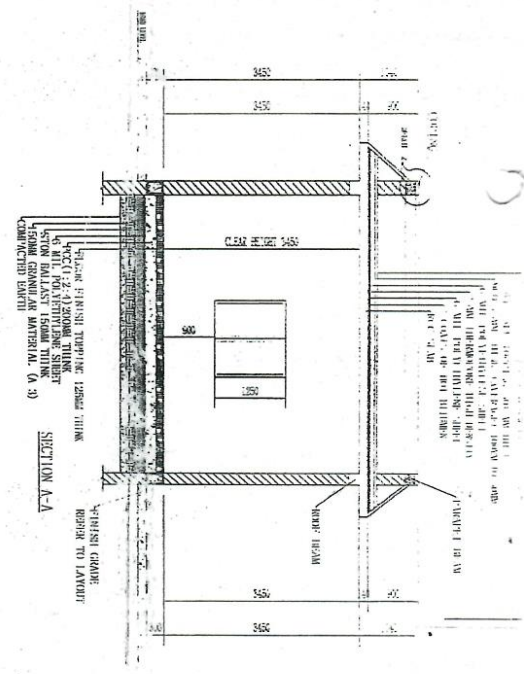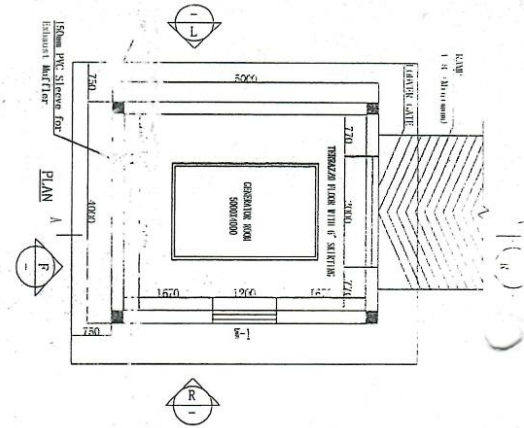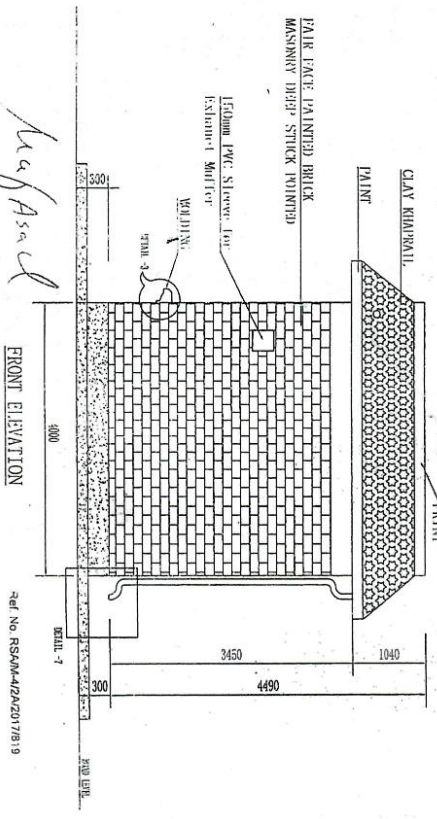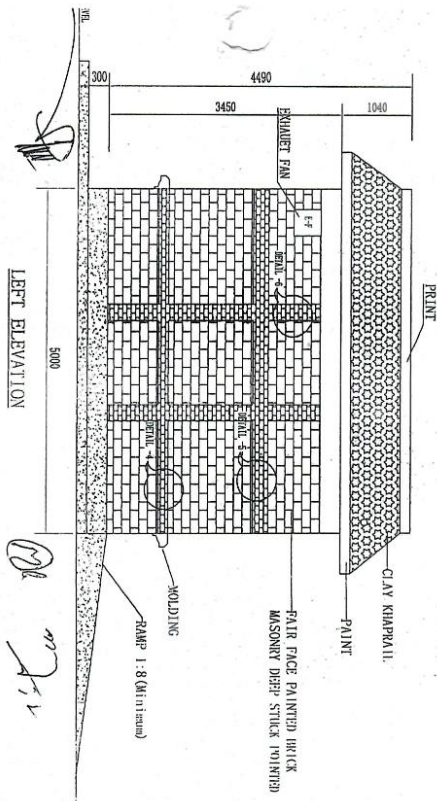

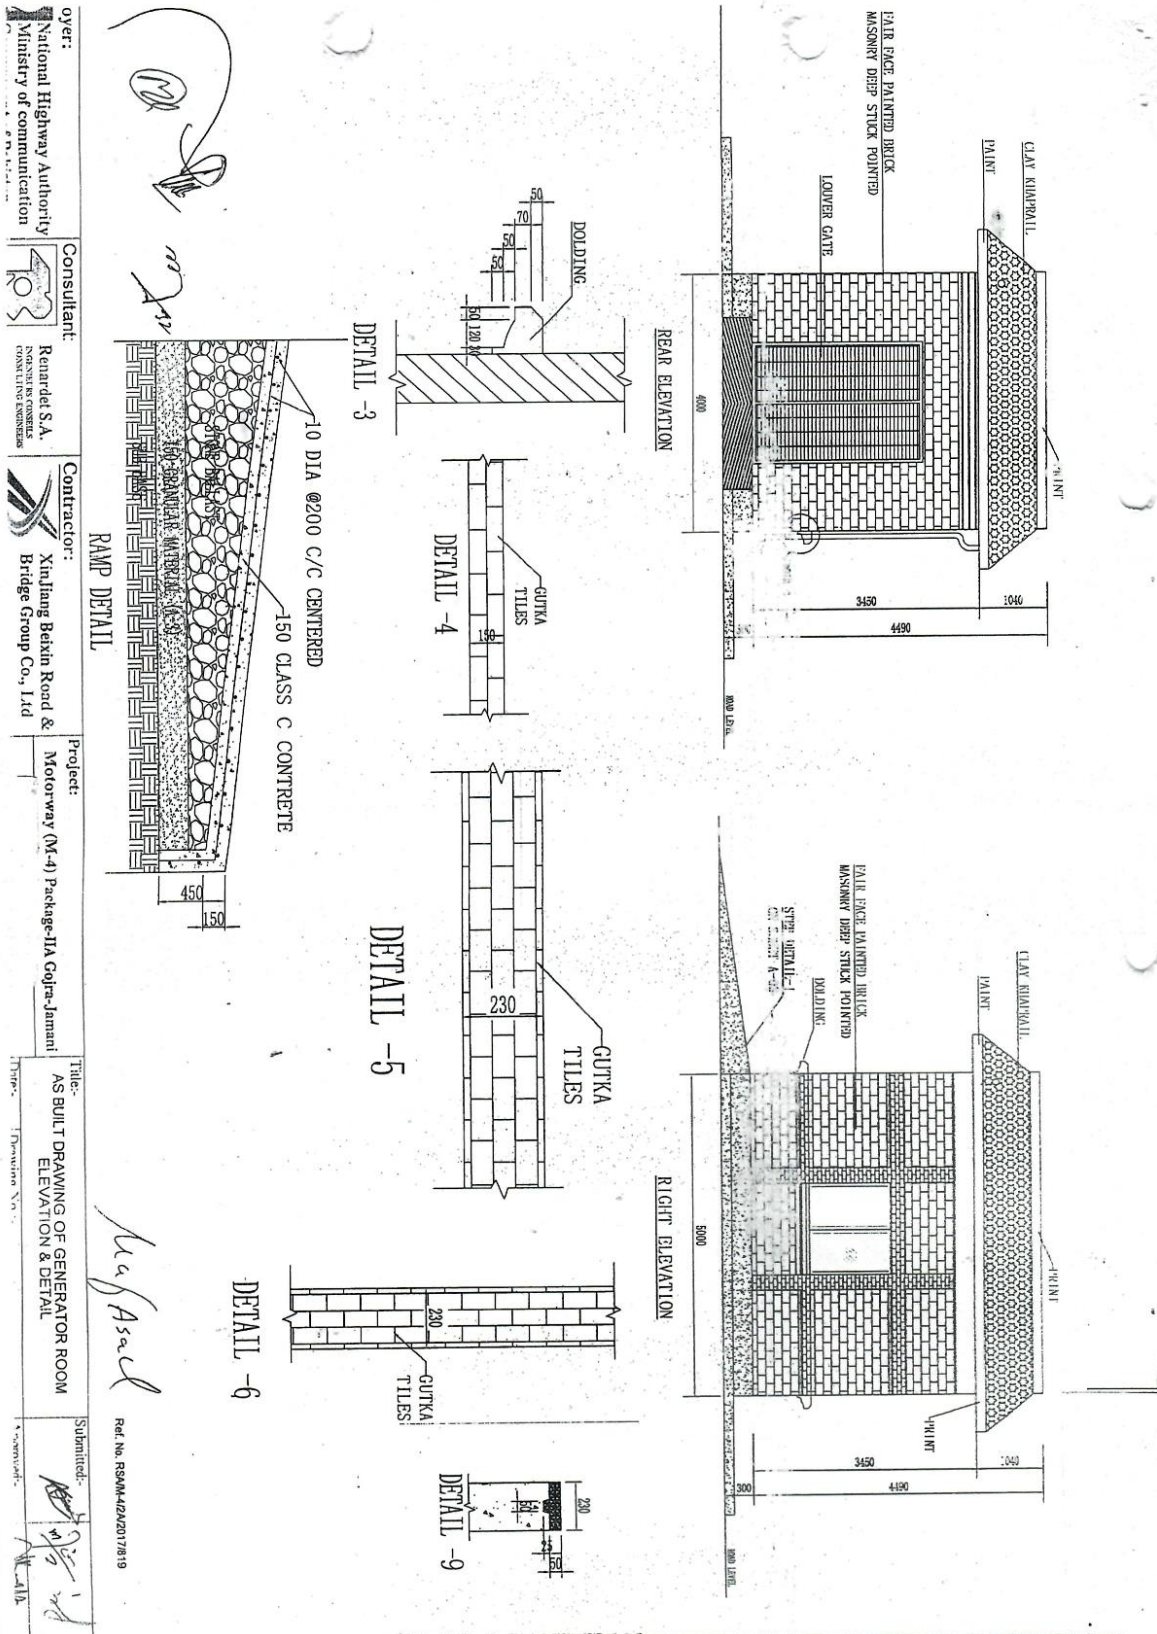

Client:
National Highway Authority
Ministry of Communication

Consultant:
Renardet S.A.
INGENIEURS CONSULTANTS
CONSTRUCTEURS


Contractor:
Xinjiang Beixin Road &
Bridge Group Co., Ltd

Project:
Motorway (M-4) Package-1/A Gdpr-Jamant



Title:
AS BUILT DRAWING OF GENERATOR ROOM
FOUNDATION & PLINTHS/INTTEL PLAN

Submitted:
Ref No: SSOM/42A/2017/19

Approved:

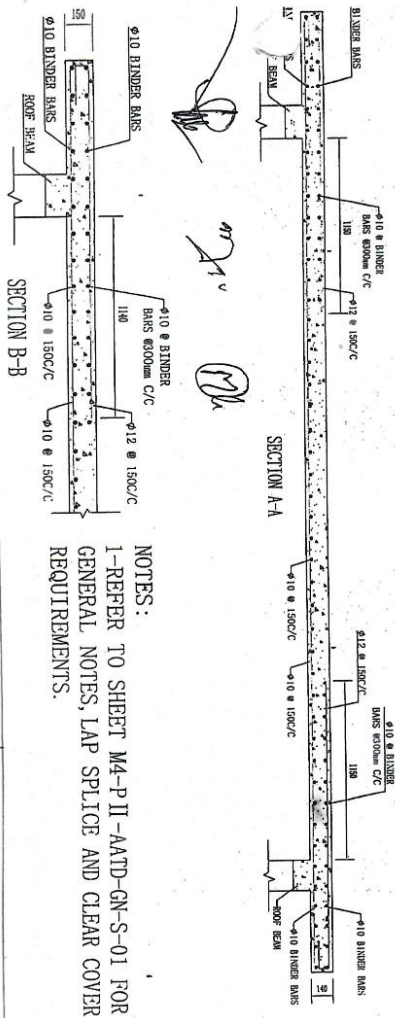

GENERATOR ROOM REIN. PLAN
& BOTT. EA SIDE

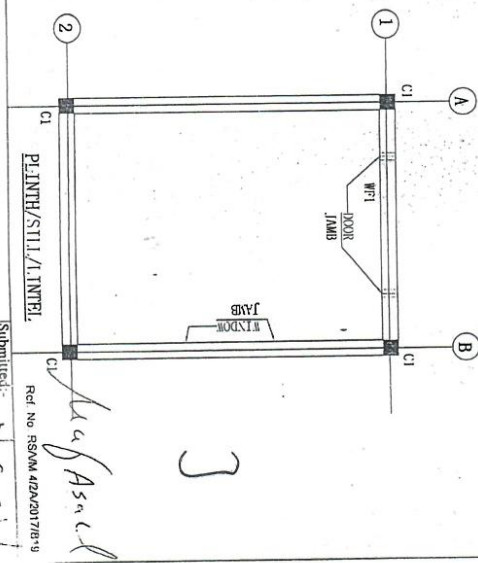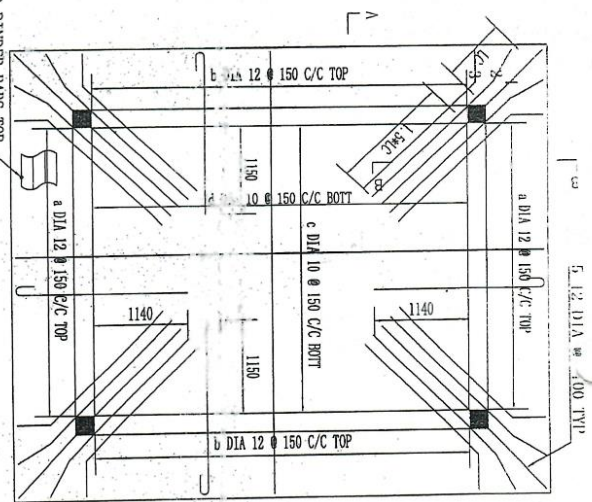

Owner:
National Highway Authority
Ministry of communication
Government of Pakistan

Consultant:
Renardel S.A.
INGENIEROS CONSULTORES
CONSTRUCTIVOS E INGENIERIA

Contractor:
Xinjiang Baixin Road &
Bridge Group Co., Ltd

Project:
Motorway (M-4) Package-IIA Gajra-Jamani

Title:
AS BUILT DRAWING OF GENERATOR ROOM
ROOF PLAN

Submitted:
Ref No. RSAM-4242017/19

Approved:
Date: 11/05/2019


Drawing No.: 94.P.A.T.D.V.A-03

ABBREVIATION	
L.P	MEANS 0" ABOVE MIN. 50 MUD
I.P1	MEANS 25" ABOVE MIN. 50 MUD
I.P2	MEANS 50" ABOVE MIN. 50 MUD

Handwritten signature

DETAIL-11

Handwritten signature

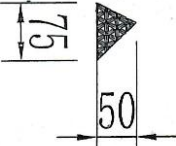


DETAIL-10

Ref No. RSAM-4242017/19


Submitted:

Approved:


ROOF PLAN

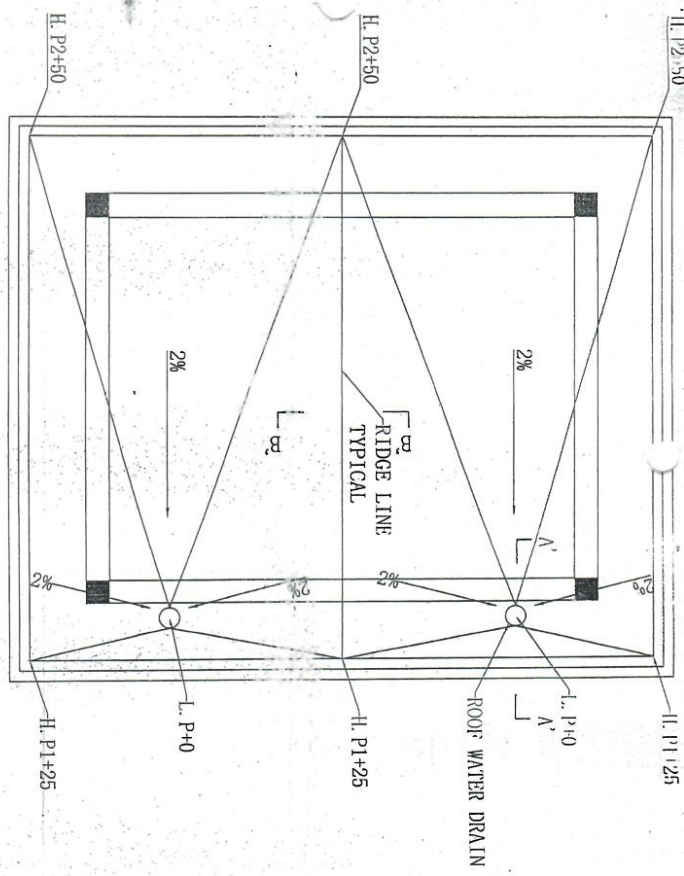

SECTION B'-B'

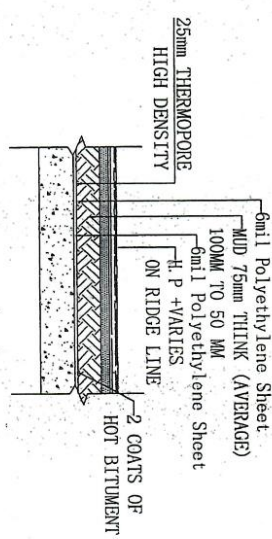

SECTION A'-A'

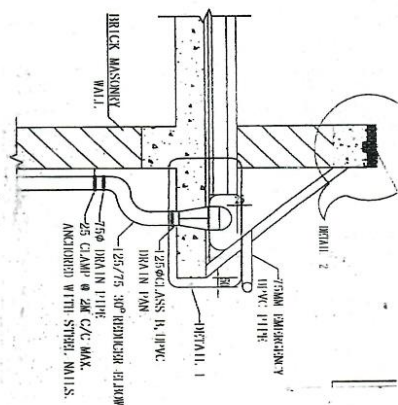

Client:
National Highway Authority
Ministry of Communication

Consultant:
Renard S.A.
PROFESSIONAL CONSULTING ENGINEERS

Contractor:
Xinjiang Beixin Road &
Bridge Group Co., Ltd



Project:
Motorway (M-4) Package-11A Gofra-Jammi

Title:
AS BUILT DRAWING OF GENERATOR ROOM
ROOF PLAN

Submitted:
Ref No. RSAM-4724207019

ABBREVIATION	
L.P	MEANS 0" ABOVE MIN. 50 MUD
L.P1	MEANS 25" ABOVE MIN. 50 MUD
L.P2	MEANS 50" ABOVE MIN. 50 MUD


ROOF PLAN

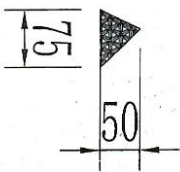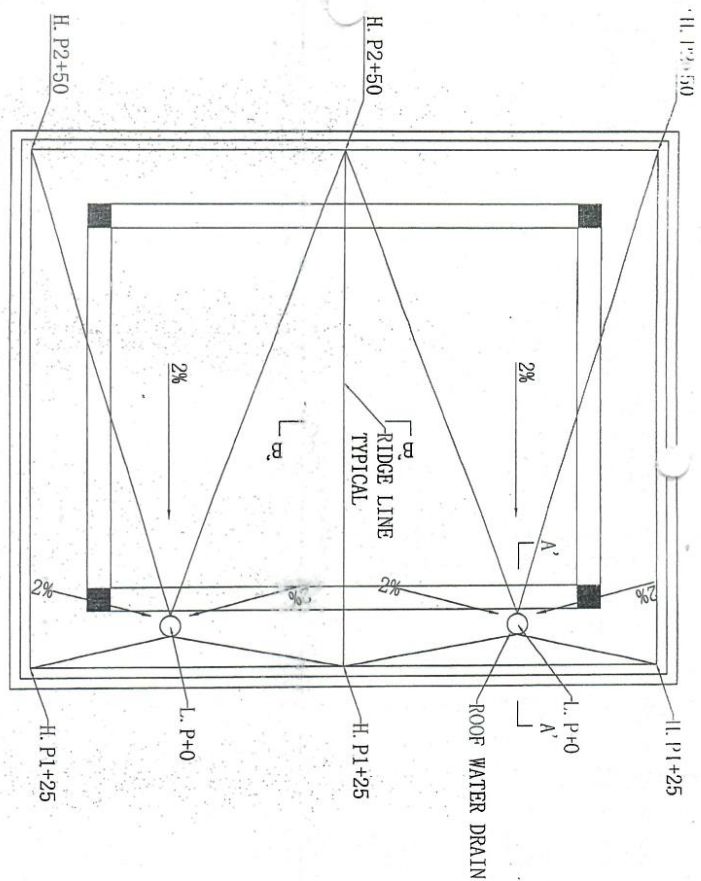



DETAIL-11

Handwritten signature

SECTION B'-B'

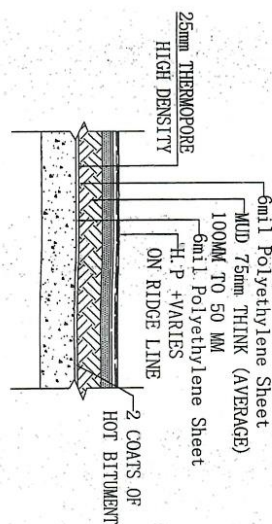


SECTION A'-A'

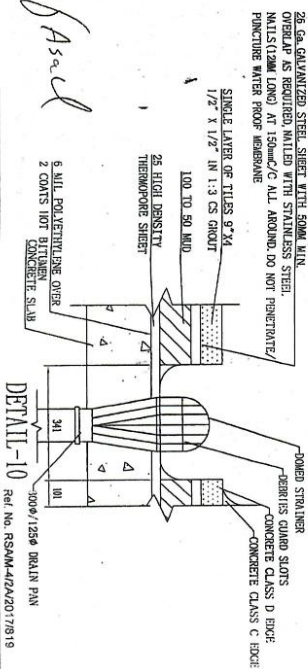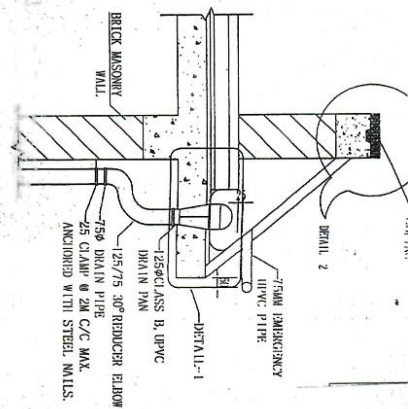


Client:	National Highway Authority Ministry of Communication
Consultant:	Renard S.A. PROFESSIONAL CONSULTING ENGINEERS
Contractor:	Xinjiang Beixin Road & Bridge Group Co., Ltd
Project:	Motorway (M-4) Package-11A Gofra-Jamini
Title:	AS BUILT DRAWING OF GENERATOR ROOM ROOF PLAN
Submitted:	Ref No. RSM-47242077019

ABBREVIATION	
L.P	MEANS 0" ABOVE MIN. 50 MUD
L.P1	MEANS 25" ABOVE MIN. 50 MUD
L.P2	MEANS 50" ABOVE MIN. 50 MUD


ROOF PLAN

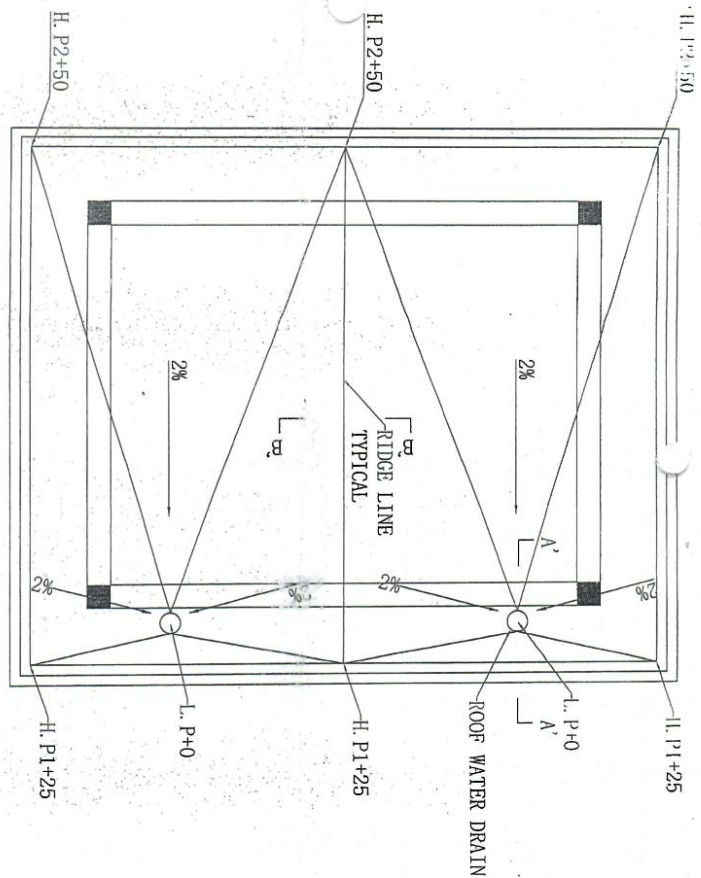


DETAIL-11

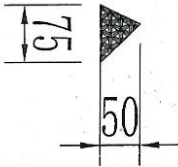


SECTION B'-B'

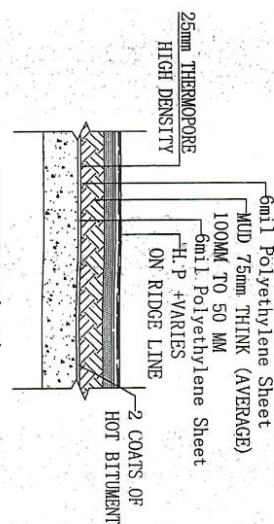

SECTION A'-A'

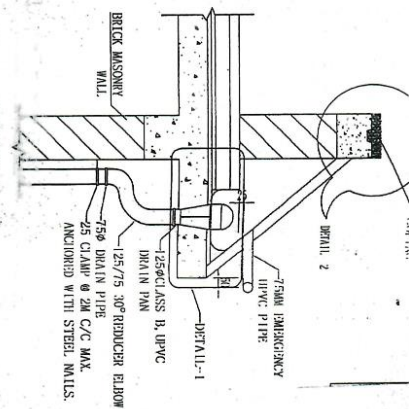



DETAIL-10

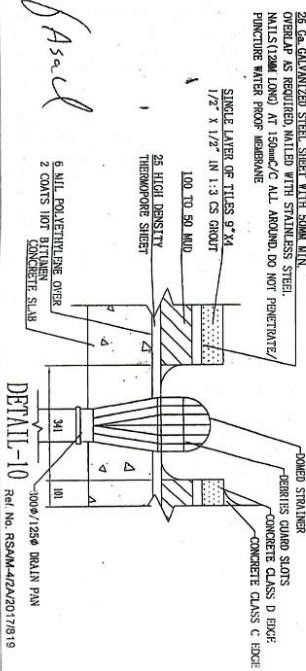





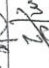
Client: National Highway Authority Ministry of Communication	Consultant: Renard S.A. ENGINEERS CONSULTANTS CONSULTING ENGINEERS	Contractor: Xinjiang Beixin Road & Bridge Group Co., Ltd	Project: Motorway (M-4) Package-11A Gajra-Jamuni	Title: AS BUILT DRAWING OF GENERATOR PAD DETAIL (2500X1300) (3000X1524)	Submitted: [Signature]
For 500KVA	For 100KVA	Approved: [Signature]	Date: 11/07/2022	Approved: [Signature]	Submitted: [Signature]

GENERATOR FOUNDATION PLAN

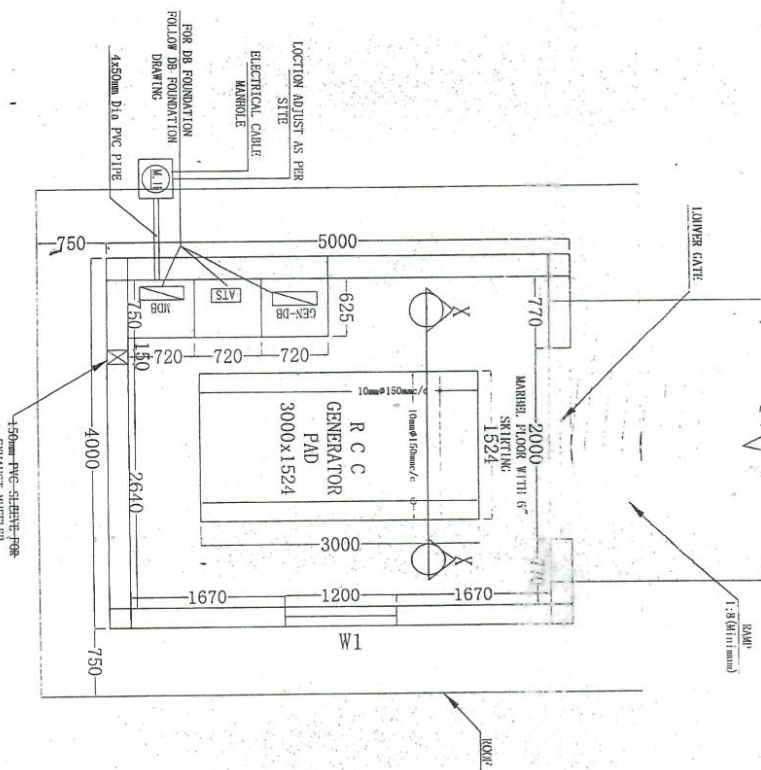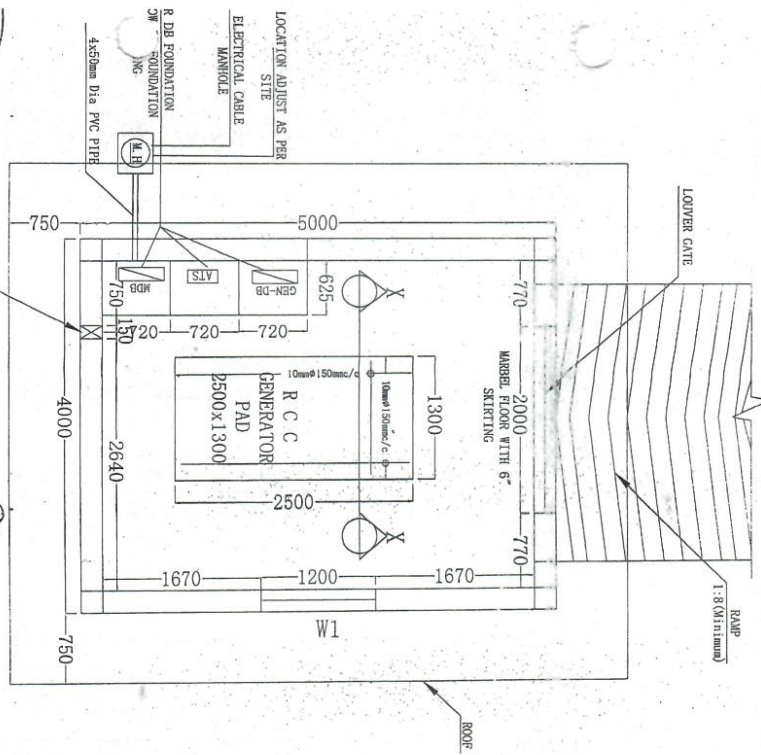GENERATOR FOUNDATION PLAN

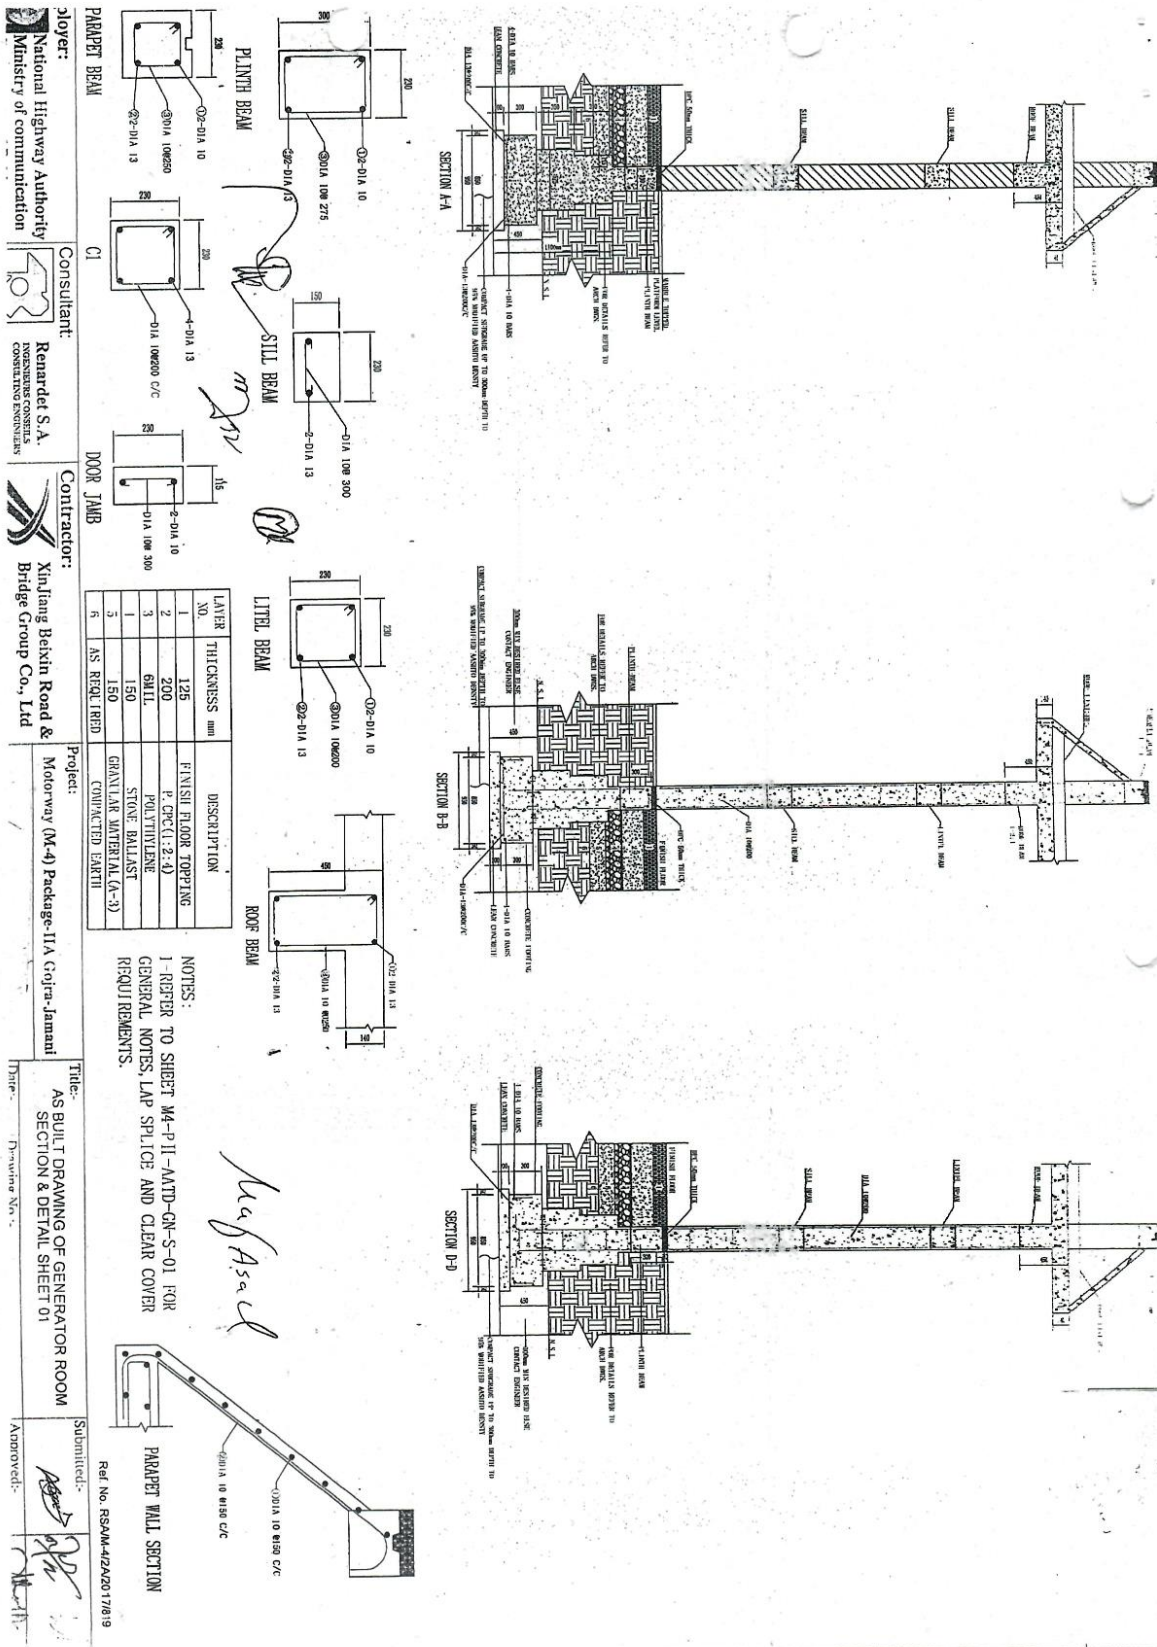





Client: National Highway Authority Ministry of Communication Government of Pakistan	Consultant:  Renardet S.A. ENGINEERS/CONSULTANTS CONSULTING ENGINEERS	Contractor:  Xinjiang Beixin Road & Bridge Group Co., Ltd	Project: Motorway (M-4) Package-IIA Gofra-Jamali	Title: AS BUILT DRAWING OF GENERATOR ROOM SECTION & DETAIL SHEET 02	Submitted:  Approved:  M. H.


LAYER NO.	THICKNESS mm	DESCRIPTION
1	125	FINISH FLOOR TOPPING
2	200	P.C.P.C. (1:2:4)
3	60ML	POLYETHYLENE
4	150	STONE BALLAST
5	150	GRAVEL MATERIAL (A.3)
6	AS REQUIRED	COMPACTED EARTH

NOTES:
 1- REFER TO SHEET M4-P-II-AATD-CN-S-01 FOR
 GENERAL NOTES, LAP SPLICE AND CLEAR COVER
 REQUIREMENTS.

Asad


Ref. No. RSAM/42A/2017/819

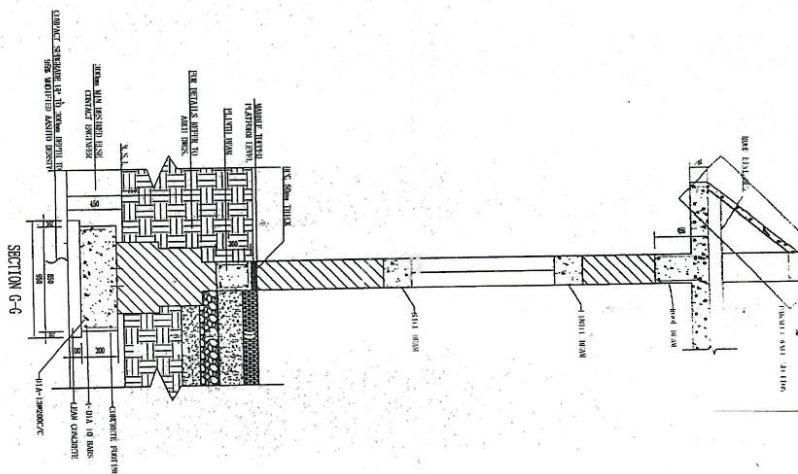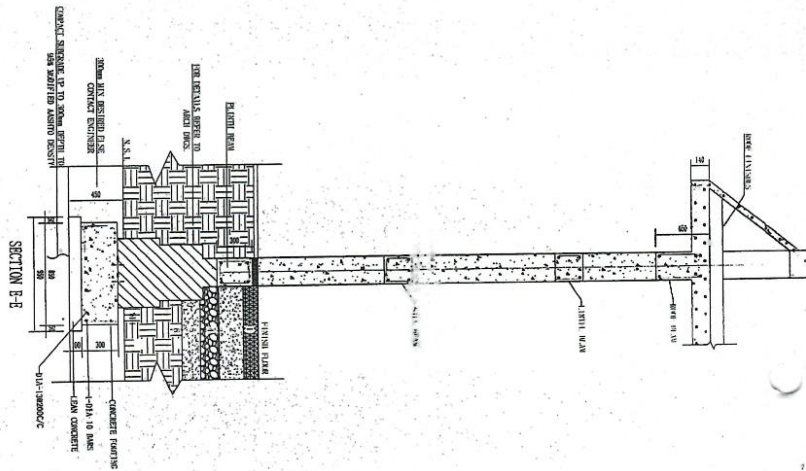

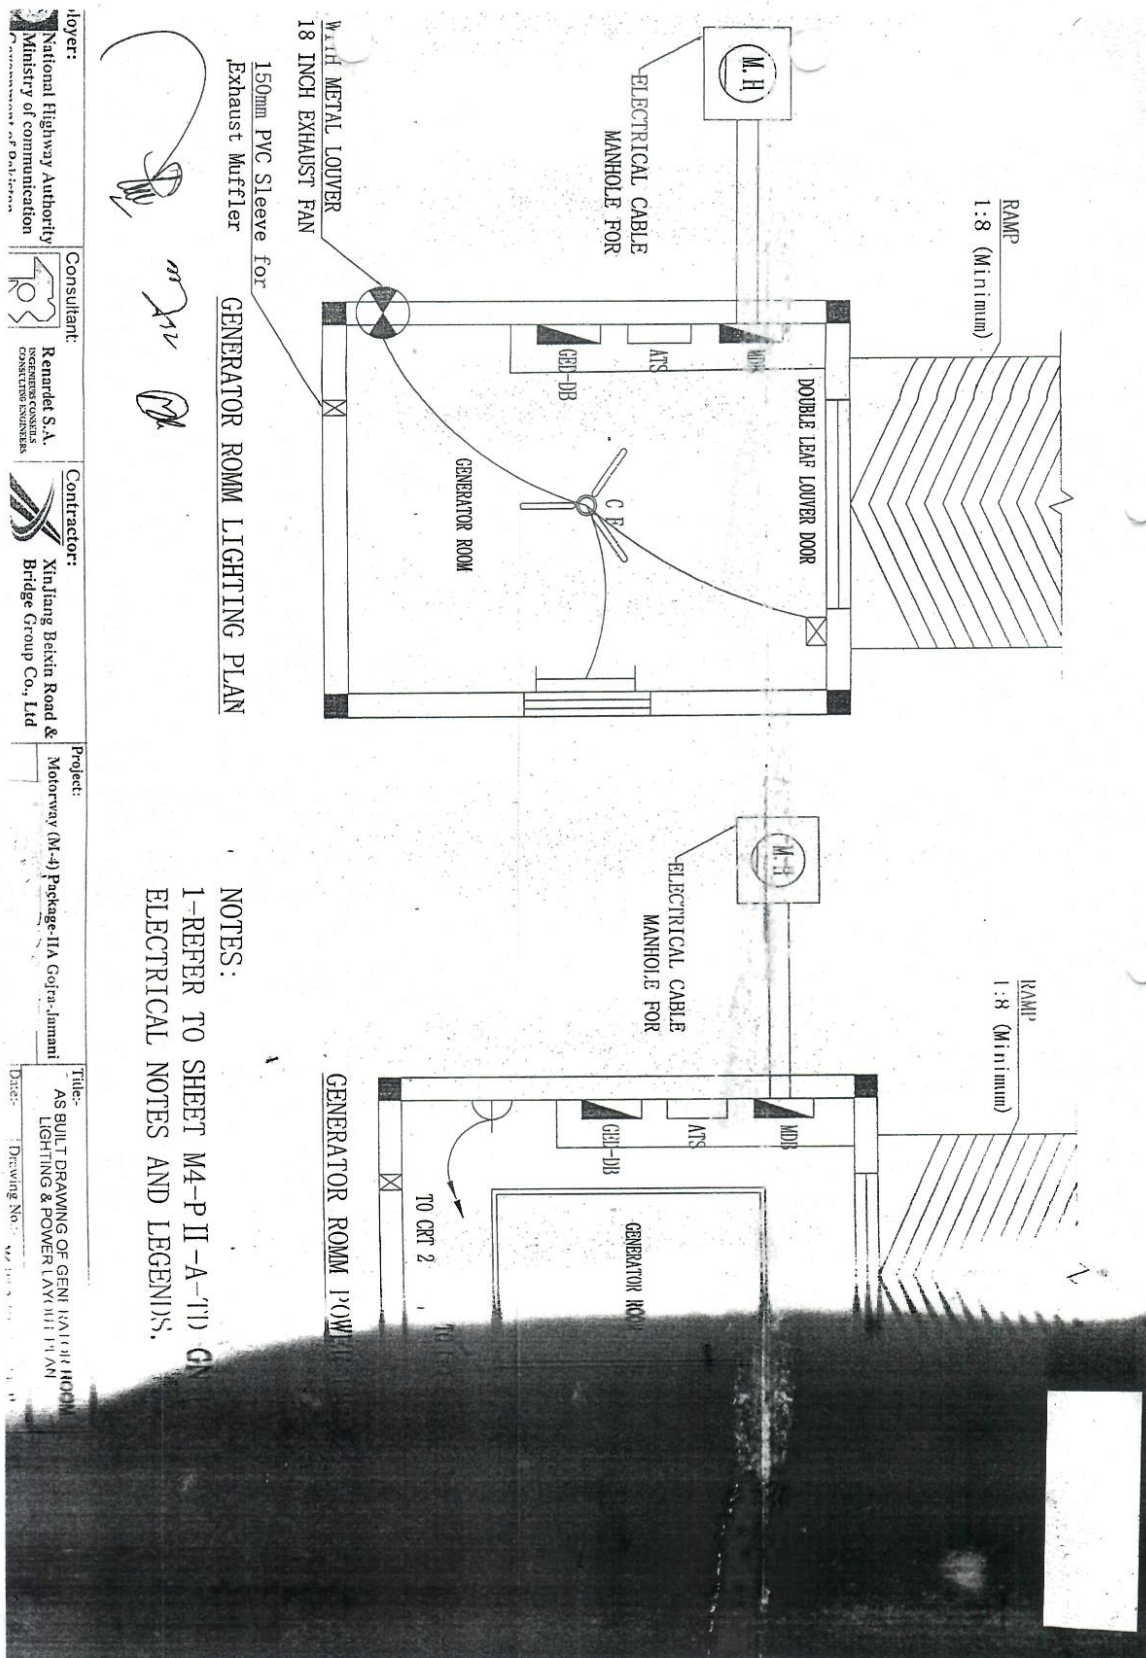

Owner:	Ministry of Communication	Consultant:	Renardet S.A. INGENIEURS CONSULTANTS	Contractor:	Xinjiang Beixin Road & Bridge Group Co., Ltd	Project:	Motorway (M-4) Package-IIA Gofra-Jamant	Title:	AS BUILT DRAWING OF GENERATOR ROOM DB DETAIL	Submitted:	Approved:
	Government of Pakistan							Date:	Drawing No.:		

Ref. No. NSAM-4/20/17/819

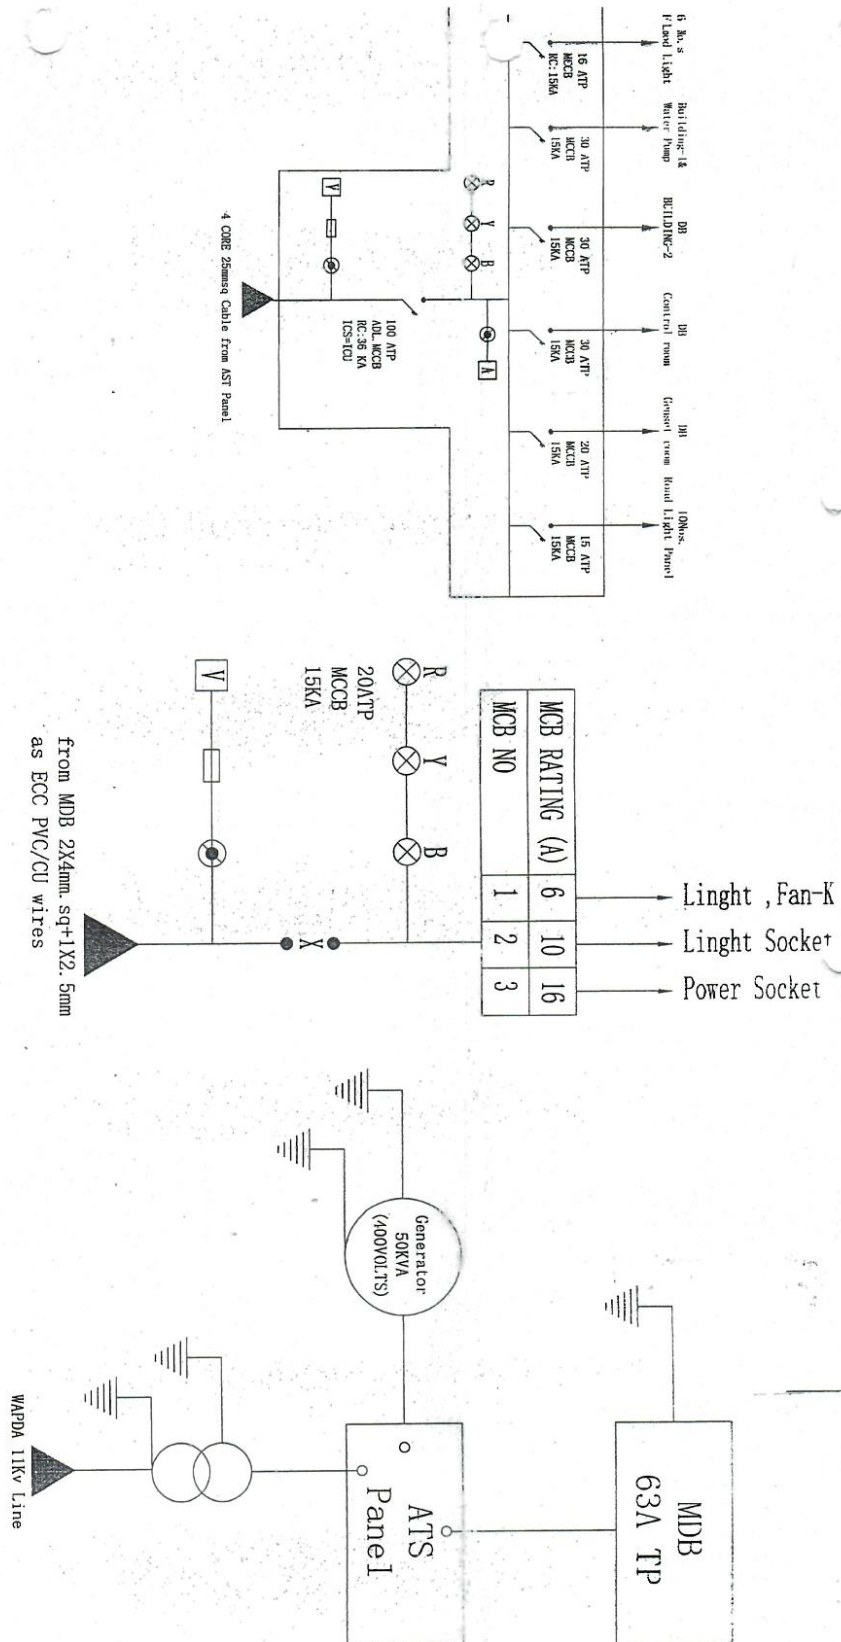

Client:
National Highway Authority
Ministry of communication


Consultant:
Renardel S.A.
CONSULTING ENGINEERS

Contractor:
Xinjiang Beixin Road &
Bridge Group Co., Ltd


Project:
Motorway (M-4) Package IIA Gd/r-Jamani

Title:
AS BUILT DRAWING OF
WEIGHT BRIDGE CONTROL ROOM AT RAMP 2 &
FLOOR PLAN, LEFT & RIGHT ELEVATION

Submitted:
Ref. No. RSAM-4/24/2017/619

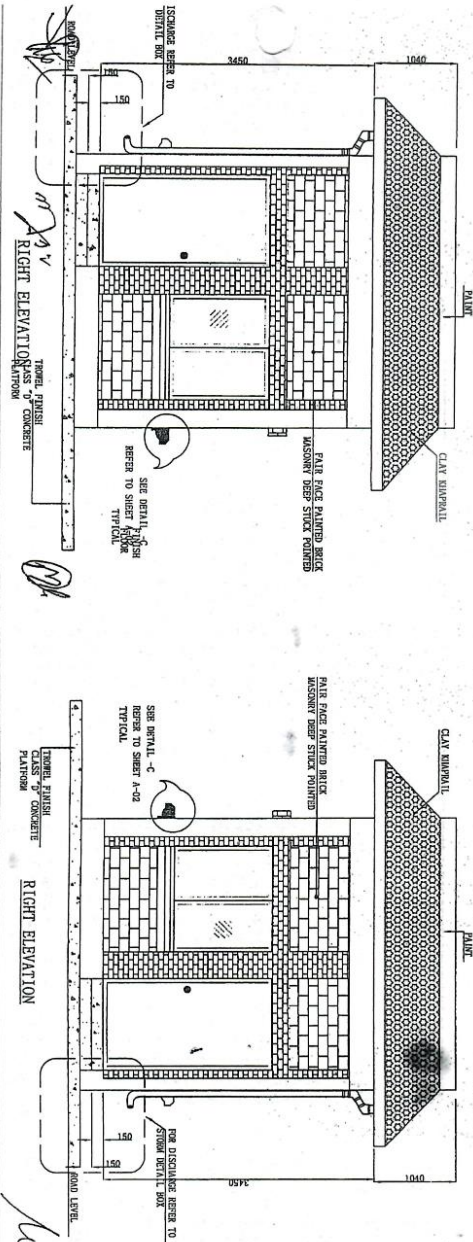

CONTROL ROOM PLAN

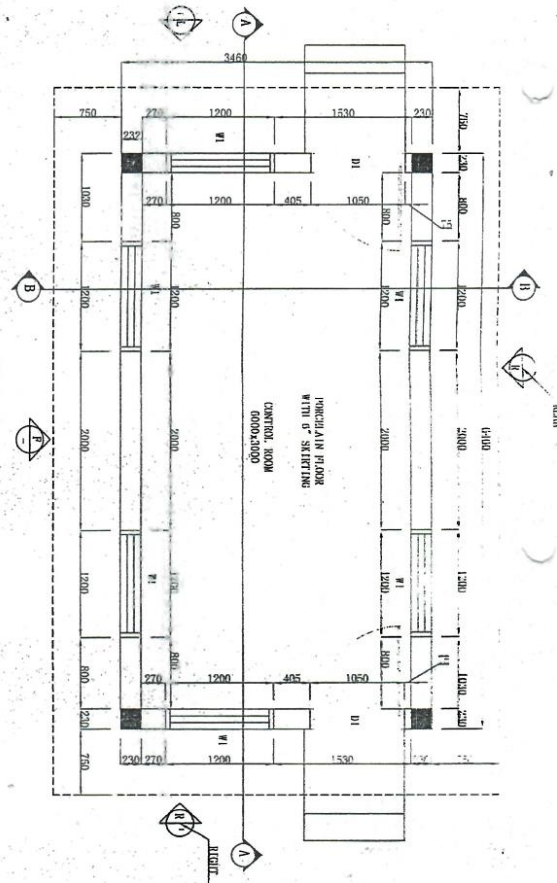

SCHEDULE OF DOOR & WINDOW			
S No.	TYPE	SIZE (mm)	NO
1	D1	1050X2150	2
2	W1	1200X1250	6

