


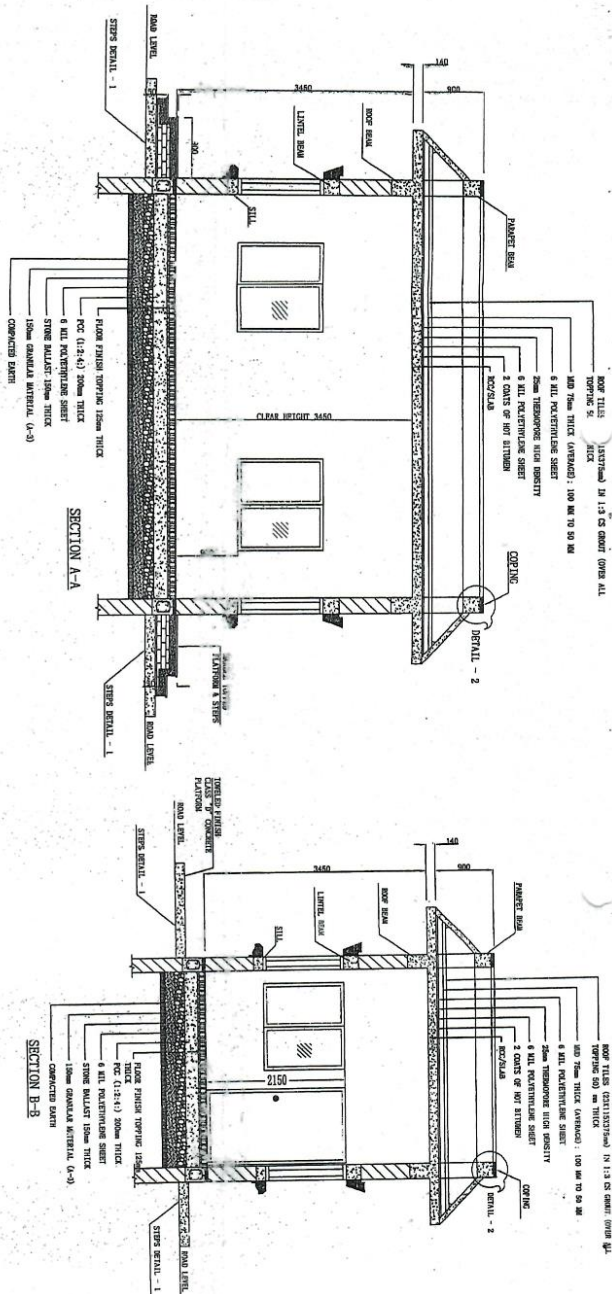
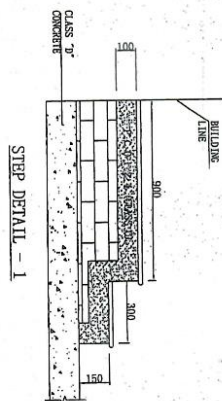


Client:	National Highway Authority Ministry of communication	Consultant:	Rumard S.A. ENGINEERING CONSULTANTS PO BOX 10000 DAMMAM	Contractor:	Xinjiang Beixin Road & Bridge Group Co., Ltd	Project:	Motorway (M-4) Package-11A (Gofa-Jamani	Title:	AS BUILT DRAWING OF WEIGHT BRIDGE CONTROL ROOM AT RAMP 2 & 4 SECTION 82 DETAIL	Submitted:	11/11/2019	Approved:	11/11/2019
---------	---	-------------	---	-------------	---	----------	---	--------	--	------------	------------	-----------	------------

Ref. No RSAM-4/2A/2017/19

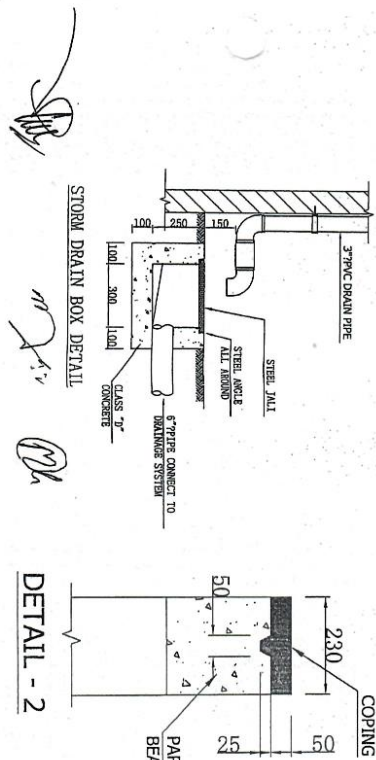

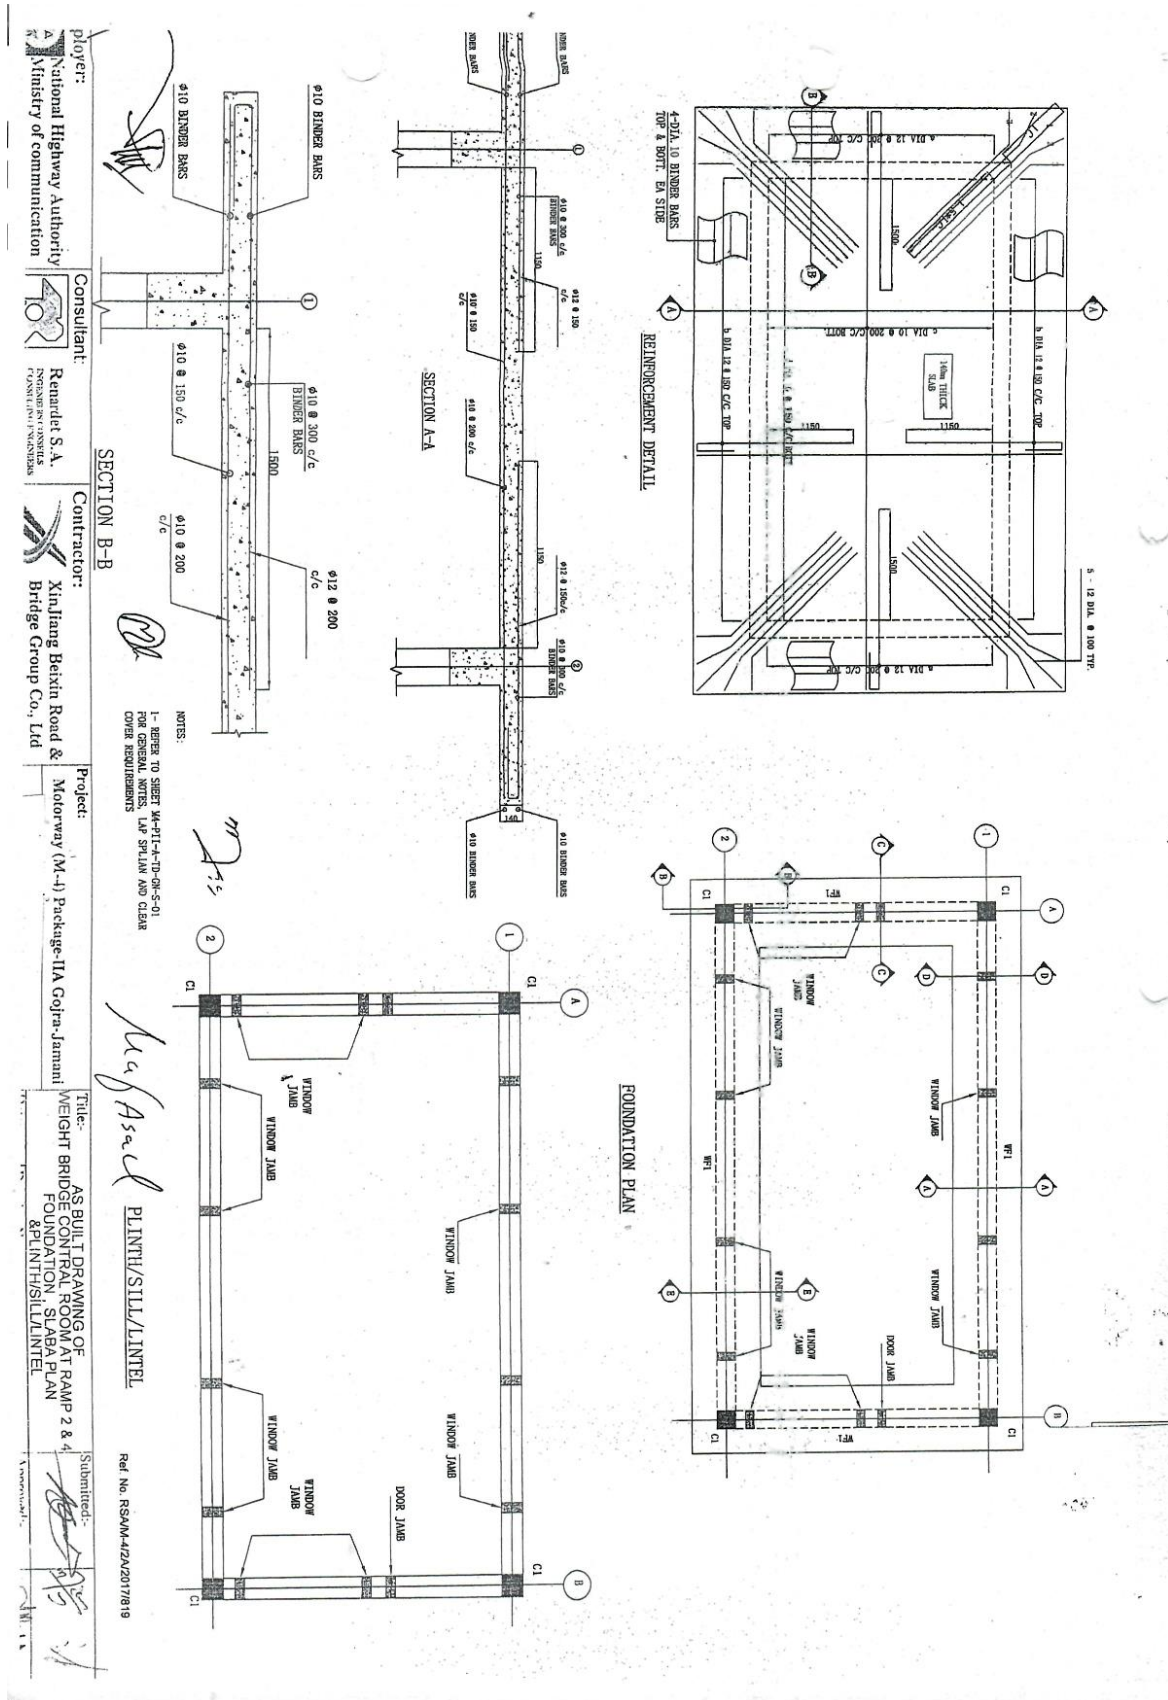

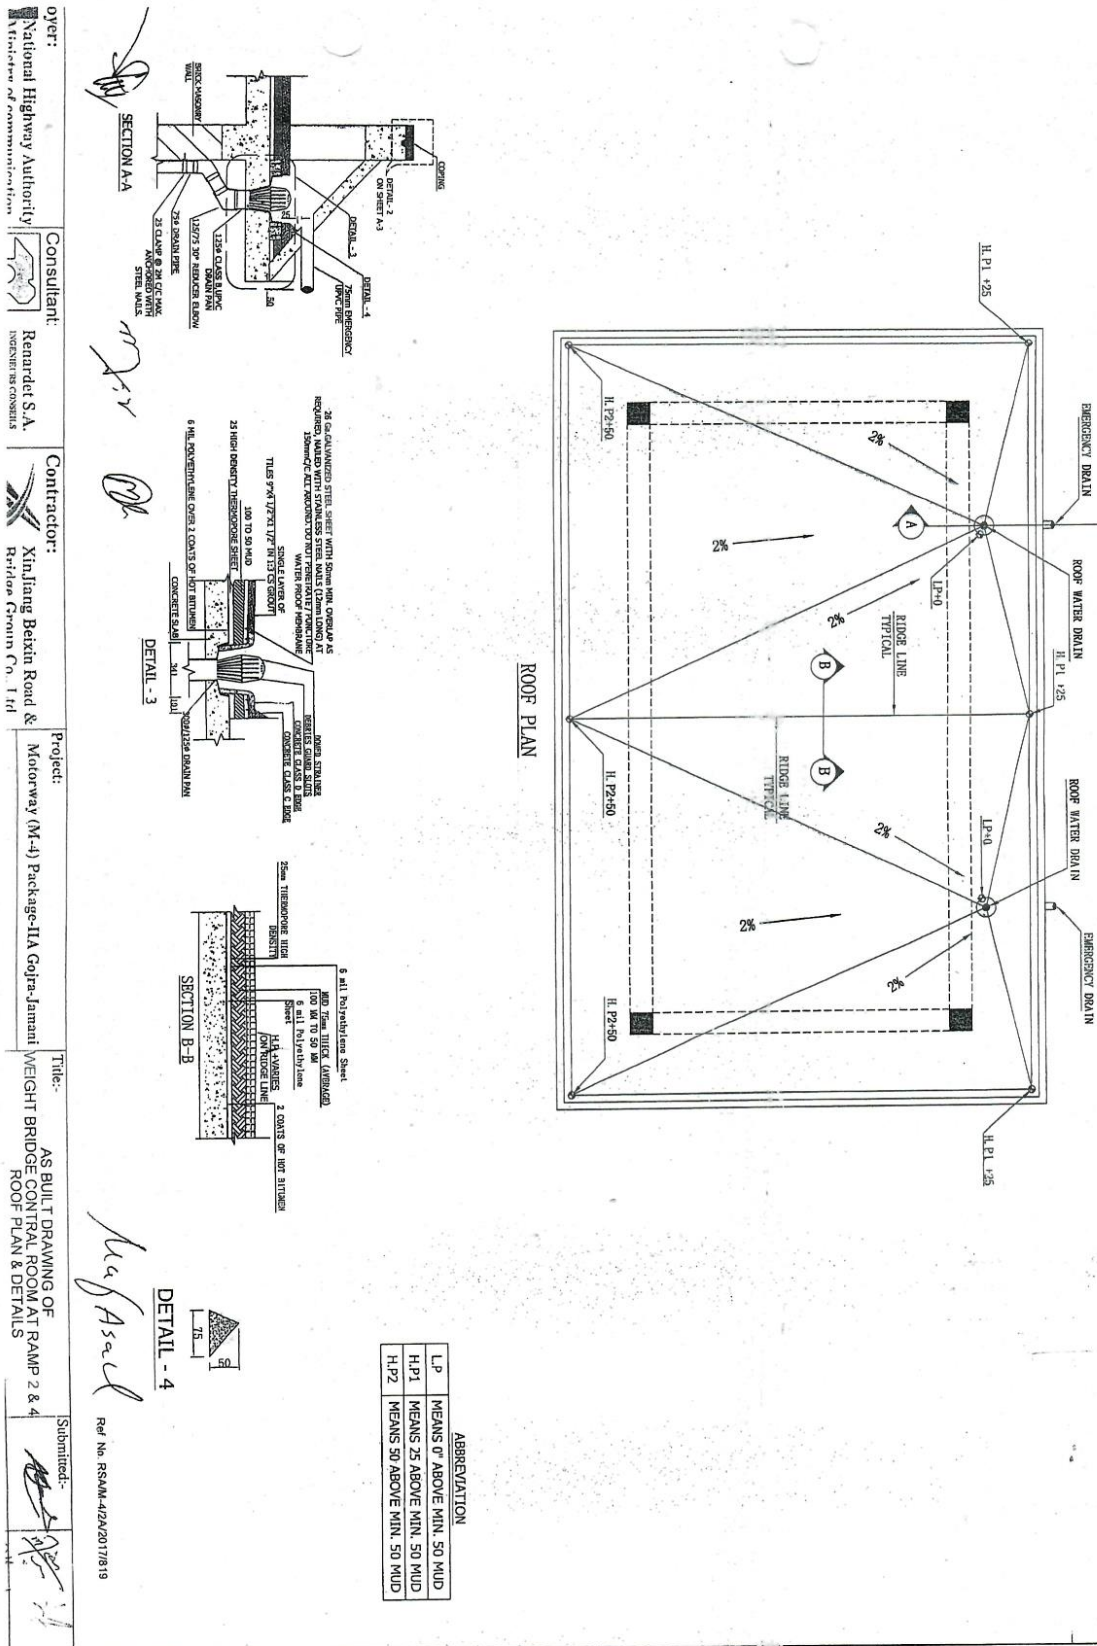

Client:
National Highway Authority
Ministry of Communication

Consultant:
Remadel S.A.
INGENIEROS CONSULTORES


Contractor:
Xinjiang Baixin Road &
Bridge Group Co., Ltd

Project:
Motorway (M-4) Package-11A Gofra-Jamani


Title:
AS BUILT DRAWING OF
WEIGHT BRIDGE CONTROL ROOM AT PAMP 2 & 4
SECTION & DETAILS SHEET 01

Submitted:
Approved:


PARAPET BEAM

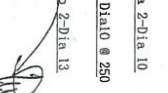


CL

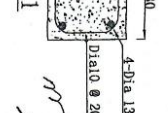

DOOR JAMB

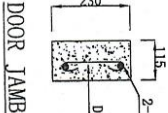

WINDOW JAMB

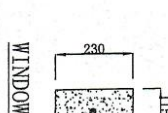


ROOF BEAM



PARAPET WALL SECTION



PLINTH BEAM

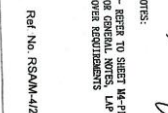


STILL BEAM





LINTEL BEAM



SECTION A-A

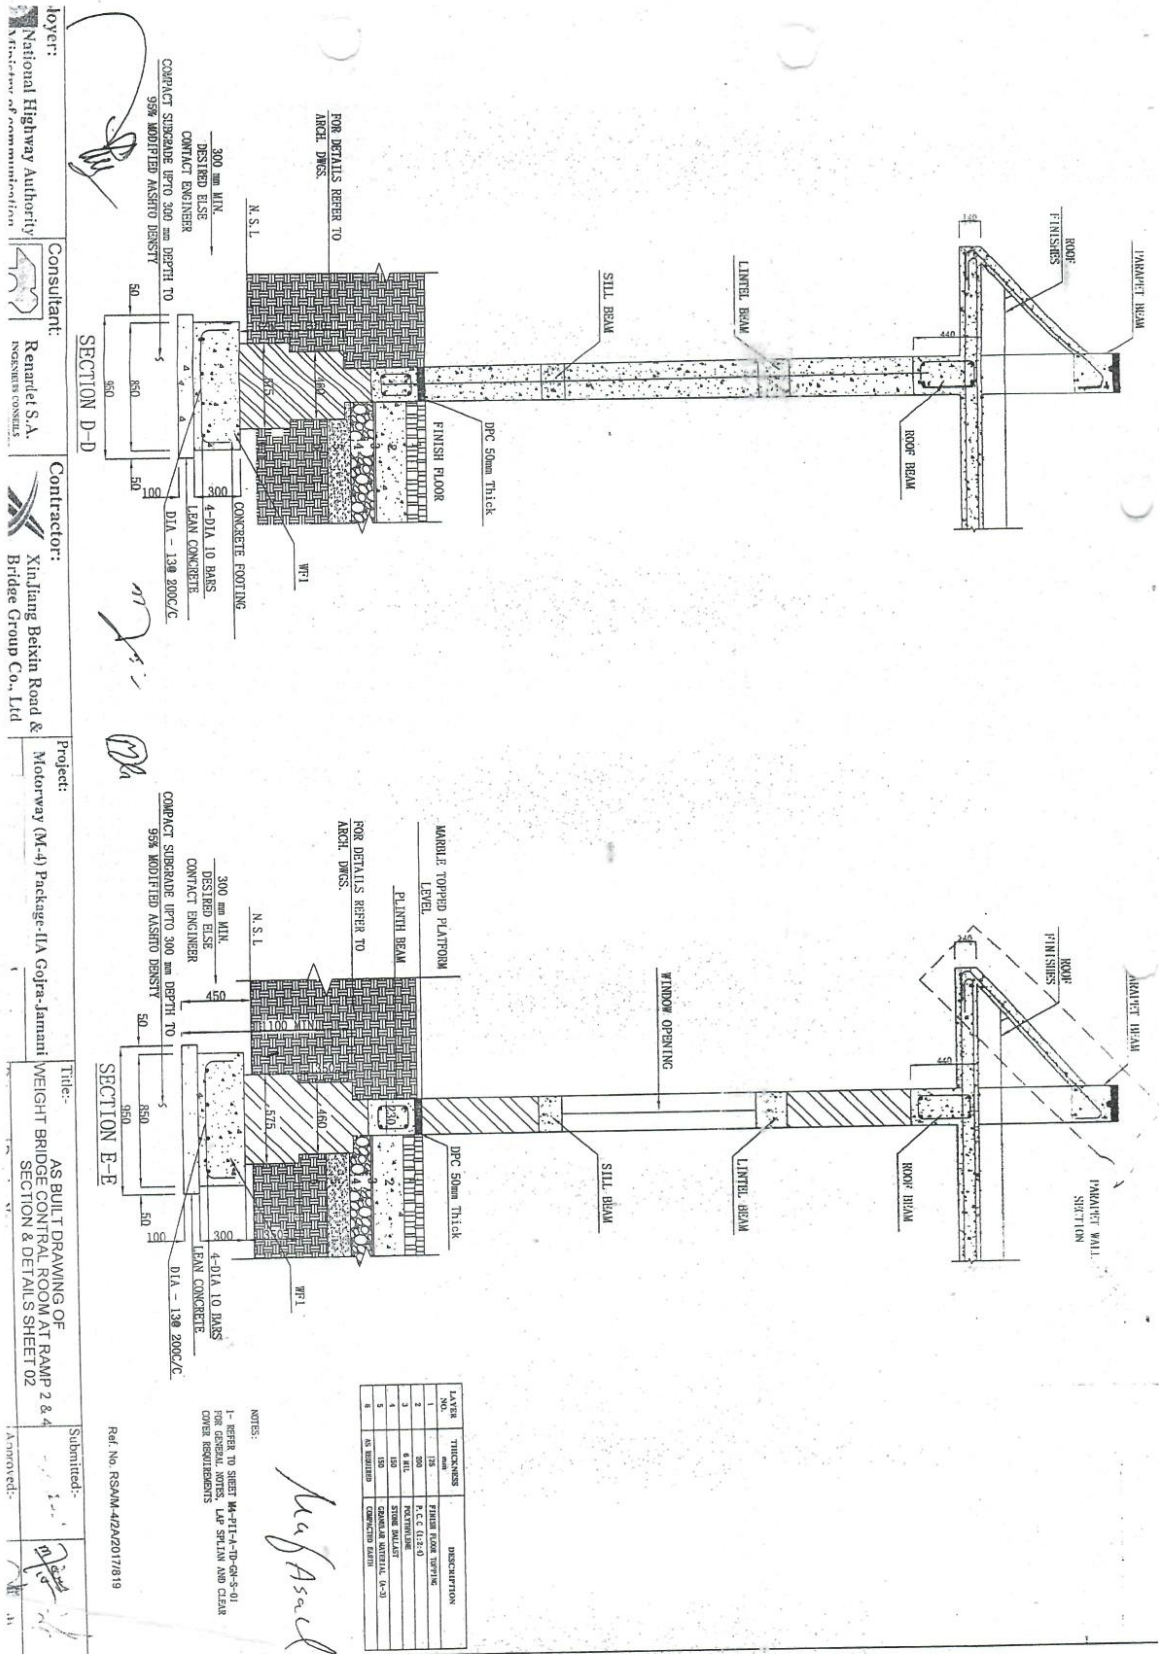

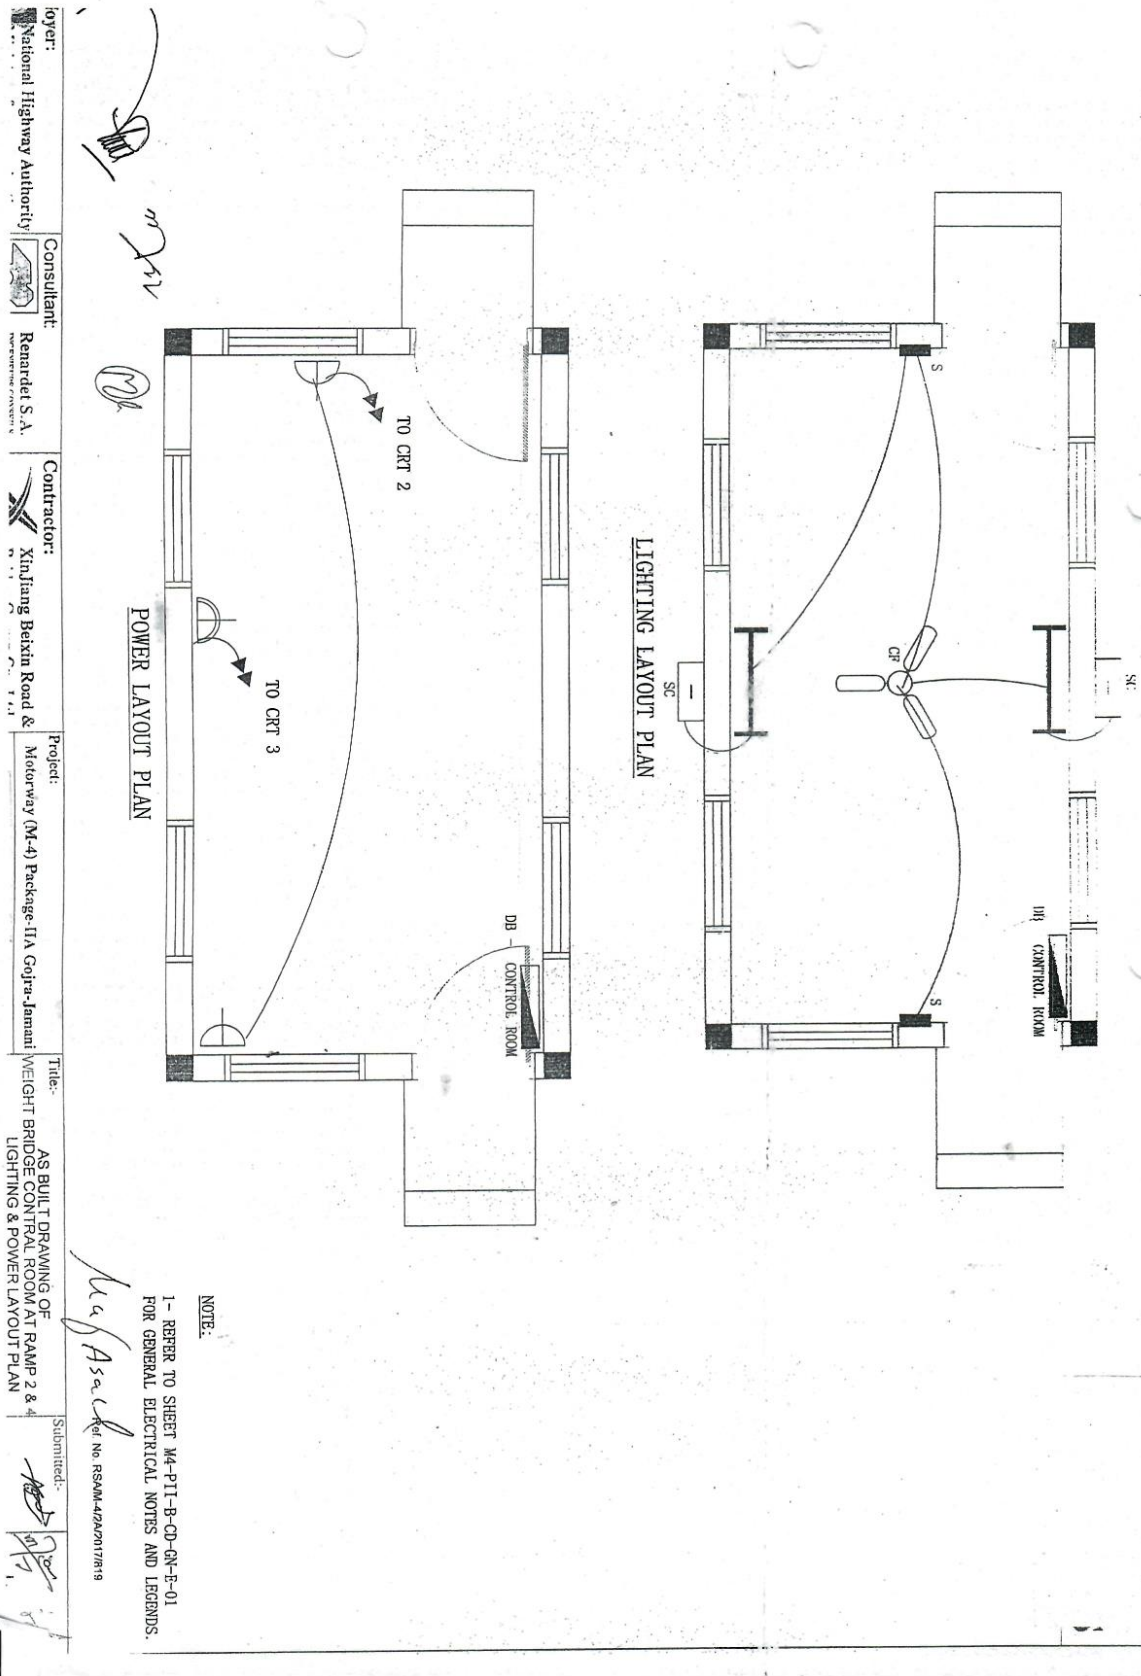

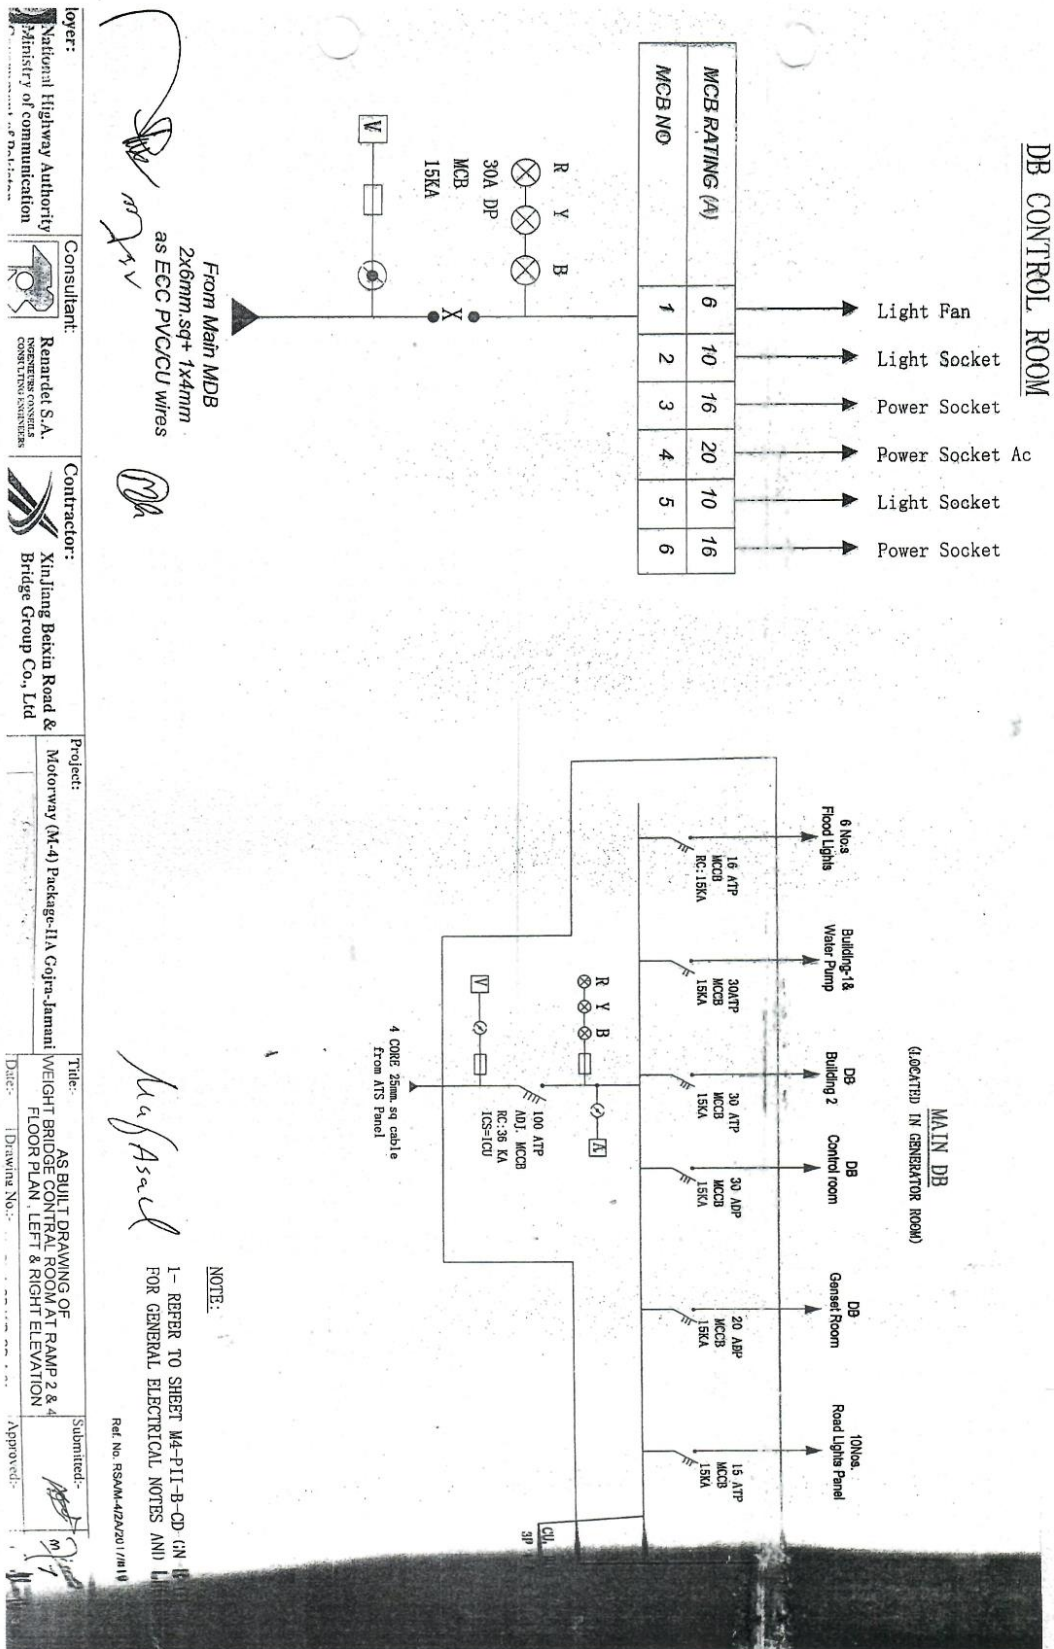

Client:
National Highway Authority
Ministry of Communication
Government of Pakistan

Consultant:
Renardet S.A.
CONSULTING ENGINEERS


Contractor:
Xinjiang Baixin Road &
Bridge Group Co., Ltd

Project:
Motorway (M-4) Package-1/A Gogra-Jamali

Title:
AS BUILT DRAWING OF OFFICE BUILDING
PLAN


Submitted:
Approved:
Date: 12/01/2019
Drawing No.: WA-PH-A-D-1/B-GA-G

SCHEDULE OF DOOR & WINDOW		
S. No.	TYPE	SIZE (mm)
D-1	1650X2150	2
D-2	900X2150	2
D-3	750X2150	2
W-1	1200X1230	4
V-1	950X1550	3
V-2	600X1550	2

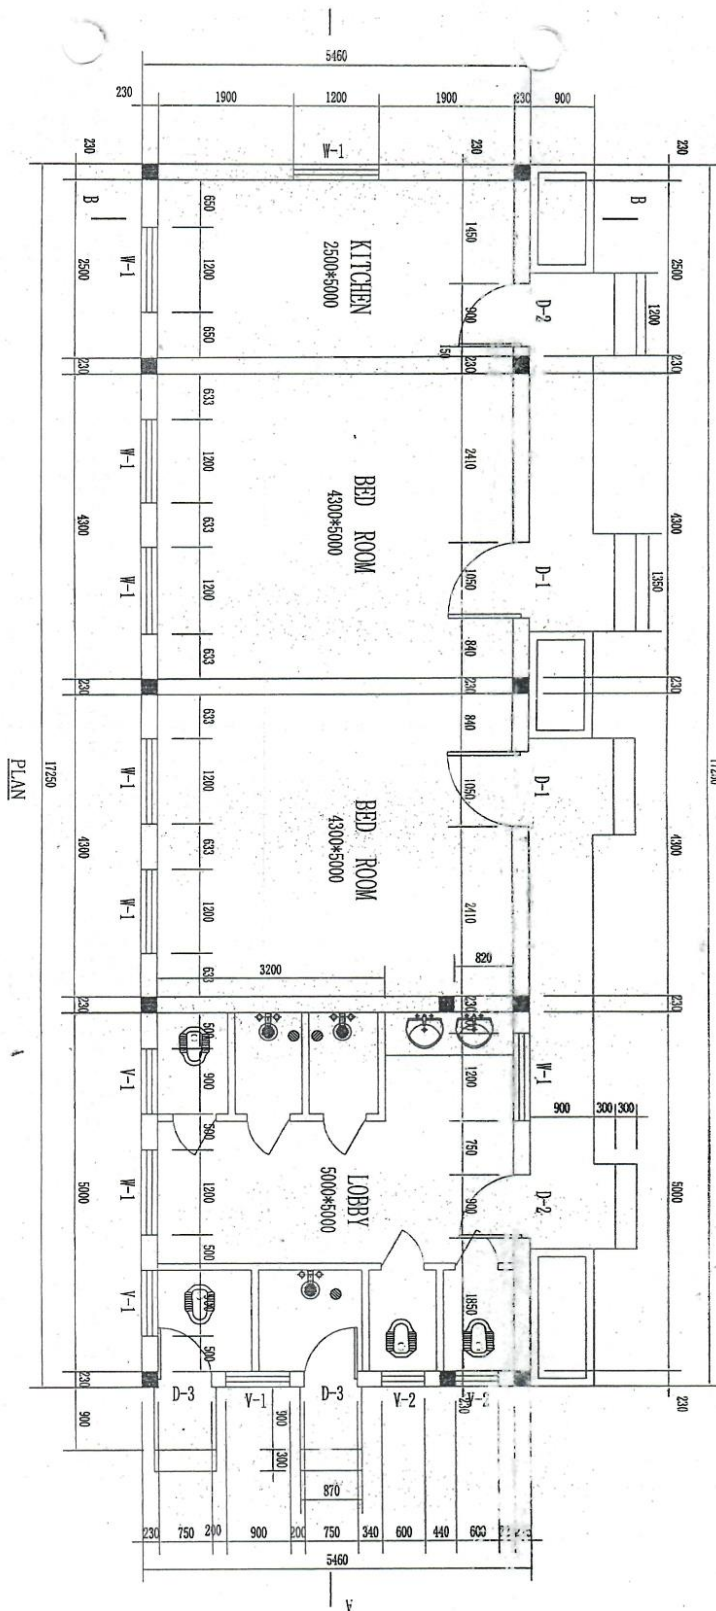

Page 9

10

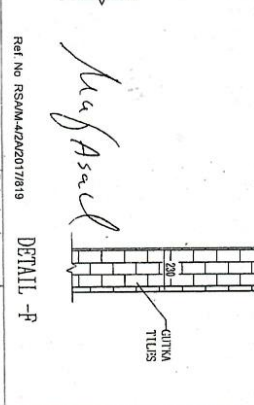



Owner:
National Highway Authority
Ministry of Communication
Government of Pakistan

Consultant:
Renardet S.A.
INGENIEUR-CONSEILS
CONSTRUCTION

Contractor:
Xinjiang Baixin Road &
Bridge Group Co., Ltd

Project:
Motorway (M-4) Package-IIA Cojra-Jamali



Title:
AS BUILT DRAWING OF OFFICE BUILDING
SLAB & SECTIONS

Date:
01-06-2019

Drawing No.:
M4-P11-A-CD-WB-03-S-02

Submitted:
Approved:

Ref. No. RSM/4/24/2017/819

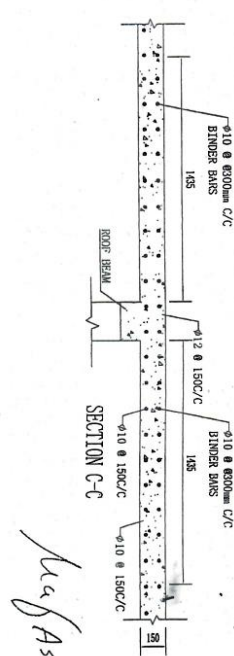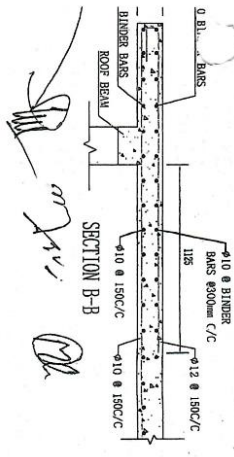

NOTES:
1-REFER TO SHEET M4-P11-AATD-CN-S-01 FOR
GENERAL NOTES, LAP SPLICE AND CLEAR COVER
REQUIREMENTS.

