


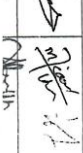
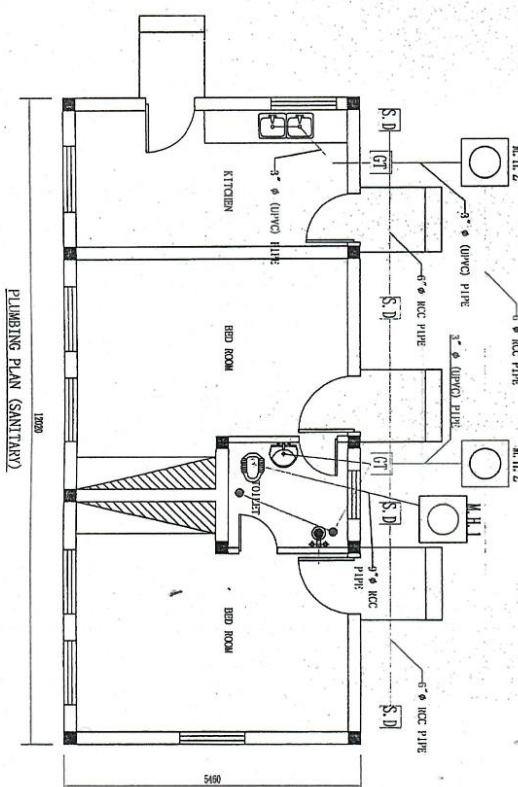



Owner: National Highway Authority Ministry of Communication	Consultant:  Renardel S.A. INGENIEROS CONSULTA CONSULTING ENGINEERS	Contractor:  Xinliang Beixin Road & Bridge Group Co., Ltd	Project: Motorway (M-4) Package-IIA Gajra-Janani	Title: AS BUILT DRAWING OF ACCOMMODATION BUILDING PLUMBING & SEWERAGE	Submitted:  Approved: 
--	---	---	--	--	---

Handwritten signature



Handwritten signature

Ref No. RSAM-42A2017/819

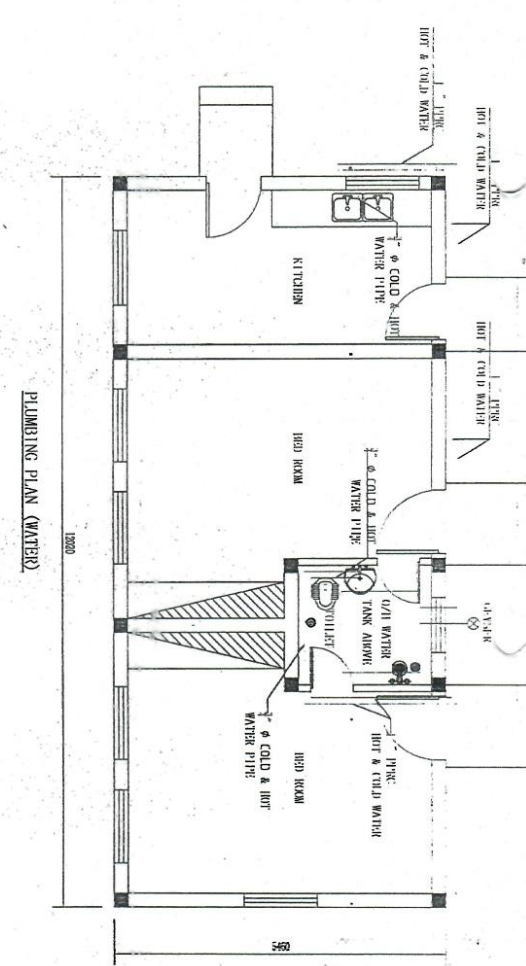

Client:
National Highway Authority
Ministry of communication

Consultant:
Remarcel S.A.
PROFESSIONAL CONSULTANT
CONSTRUCTION SERVICES

Contractor:
Xinjiang Beixin Road &
Bridge Group Co., Ltd

Project:
Motorway (M-4) Package-IIA Gogra-Jamali

Title:
AS BUILT DRAWING OF ACCOMMODATION BUILDING
LIGHTING & POWER LAYOUT PLAN

Date:
Drawing No.:
Ref. No. RSAM-4242017/19

Submitted:-

Approved:-

Ref. No. RSAM-4242017/19

Ref. No. RSAM-4242017/19

LIGHTING LAYOUT PLAN ACCOMMODATION BUILDING

NOTES:

1-REFER TO SHEET M4-P11-AATD-CN-E-FOR
ELECTRICAL NOTES.
2-REFER TO SHEETS M4-P11-AATD-CN-E-01 OR 02
LIGHTING PROTECTION & GROUNDING DETAILS.


Ref. No. RSAM-4242017/19

Ref. No. RSAM-4242017/19
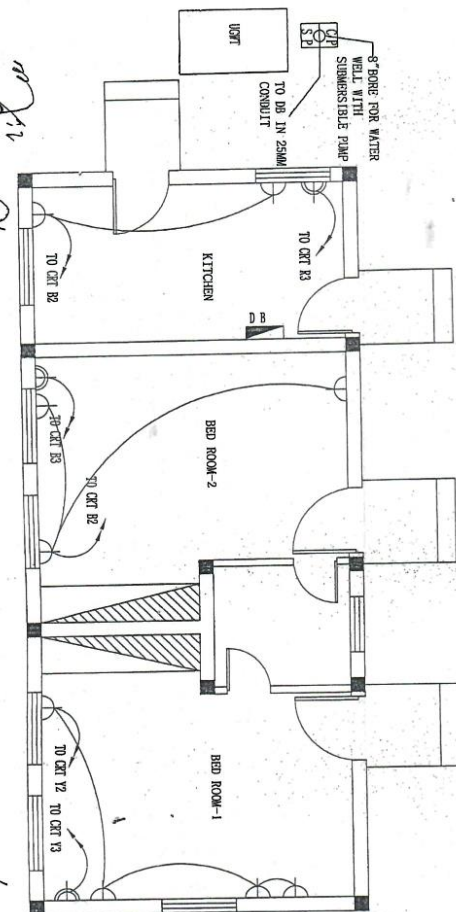

LIGHTING LAYOUT PLAN ACCOMMODATION BUILDING

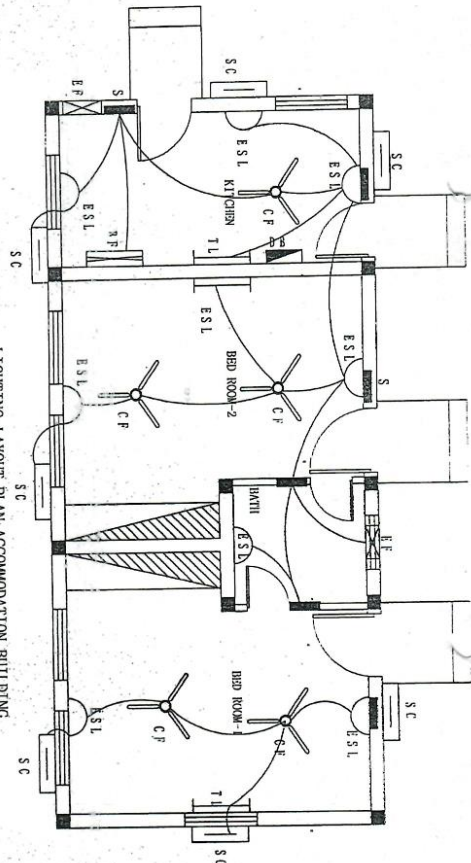

NATIONAL HIGHWAY AUTHORITY
MINISTRY OF COMMUNICATIONS
GOVERNMENT OF PAKISTAN



Contractor:
Xinjiang Baixin Road &
Bridge Group Co., Ltd

Project:
Motorway (M-4) Package-IIA Gogra-Jamrud

Title:
AS BUILT DRAWING OF
RAINFALL WEIGHT BRIDGE
RCC LINK ROAD


Date:
11.10.2019

Submittal:
APPROVED


Handwritten signature

Handwritten signature


TRANSVERSE JOINT
SEE DETAIL-3

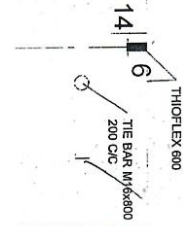


EXPANSION JOINT
SEE DETAIL-2

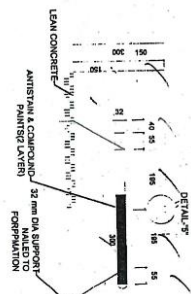

CONTRACTION JOINT
SEE DETAIL-1

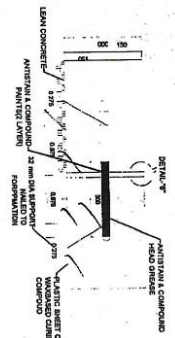

CONTRACTION JOINT
SEE DETAIL-1

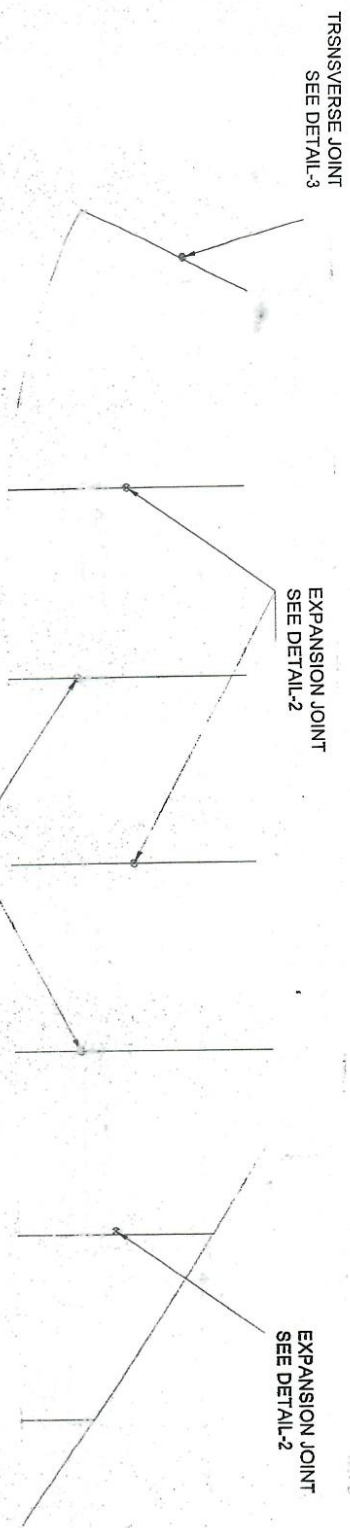

ATONAL HIGHWAY AUTHORITY
MINISTRY OF COMMUNICATIONS
GOVERNMENT OF PAKISTAN



CONTRACTOR:
Xinjiang Bekin Road &
Bridge Group Co., Ltd

DATE: 10/05/2021
RECOMMENDED
C/E, A/E, S


FAISALABAD-MULTAN MOTORWAY (M4)
GOIRA-SHORROT SECTION
(PACKAGE-II)

DATE: 10/05/2021
AS BUILT DRAWING
WEIGHT BRIDGE PLAN OF
RAMP 1&2
Drawing No.

SUBMITTED-
APPROVED-
10/05/2021

Handwritten signature and initials

Handwritten signature: Asif Asad

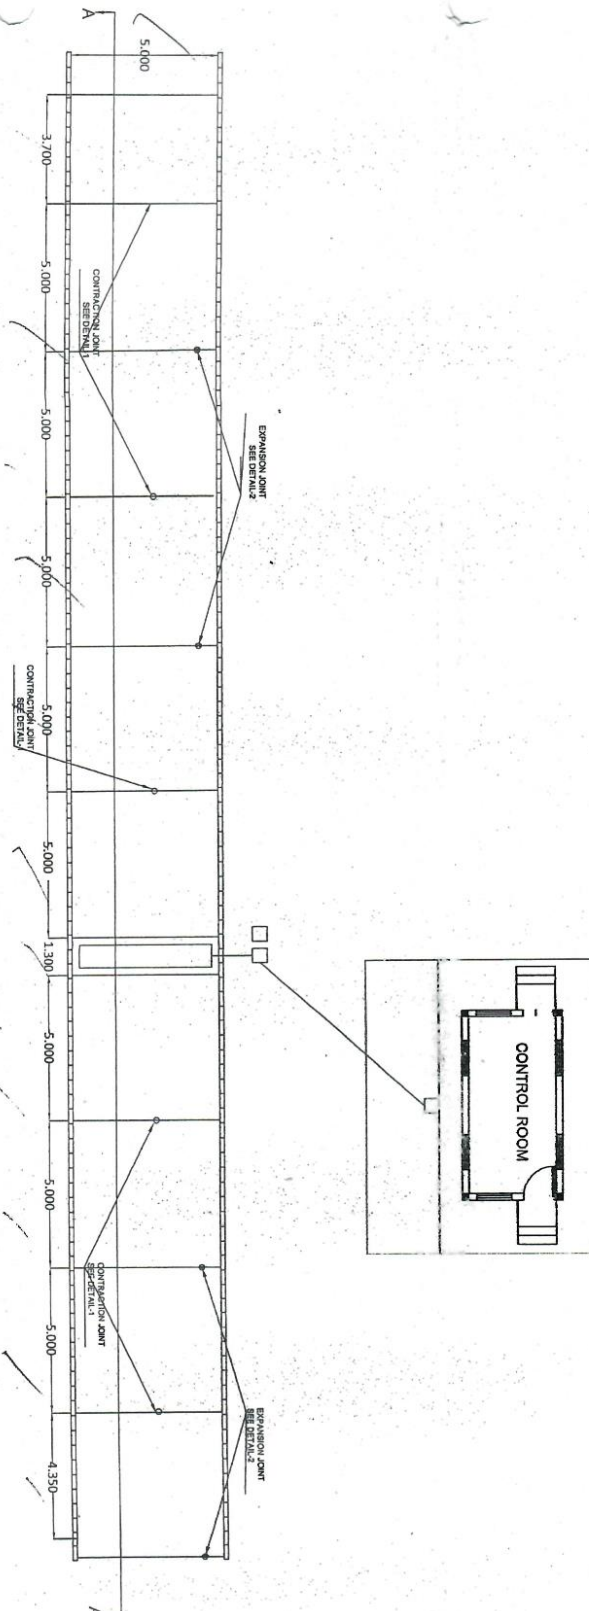



NATIONAL HIGHWAY AUTHORITY
MINISTRY OF COMMUNICATIONS

RENARDET
CONSULTING ENGINEERS
Geneve - Switzerland

Contract No.:

Xinjiang Bektin Road &
Bridge Group Co., Ltd

DATE
CDS/ATL

WORKING DRAWING

FAISALABAD-AJUTAN MOTORWAY (M4)
GOORA-SHORROT SECTION
(PACKAGE-II)

DATE

AS BUILT DRAWING OF
STEEL DETAIL OF
WEIGHT BRIDGE

DRAWING No.

SUBMITTED-

BY

DATE

APPROVED-


DATE

[Signature]

[Signature]

[Signature]

[Signature]

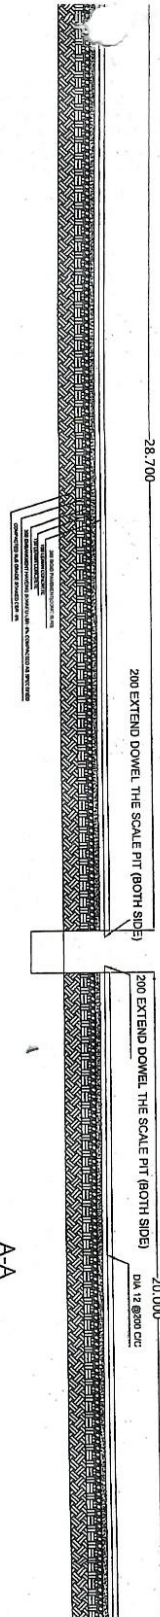

TOP ELEVATION

