

Client: National Highway Authority  
Ministry of communication




Consultant: Raurdet S.A.  
INGENIEROS CONSULTORES  
PONTIFICIA UNIVERSIDAD CATOLICA DE CHILE

Contractor: Xinjiang Beixin Road & Bridge Group Co., Ltd


Project: Motorway (M-4) Package-11A Colpa-Jamami


Title: AS BUILT DRAWING OF WEIGHT BRIDGE CONTROL ROOM AT RAMP 2 & 4 SECTION 82 DETAIL

Submitted: [Signature]  
Approved: [Signature]

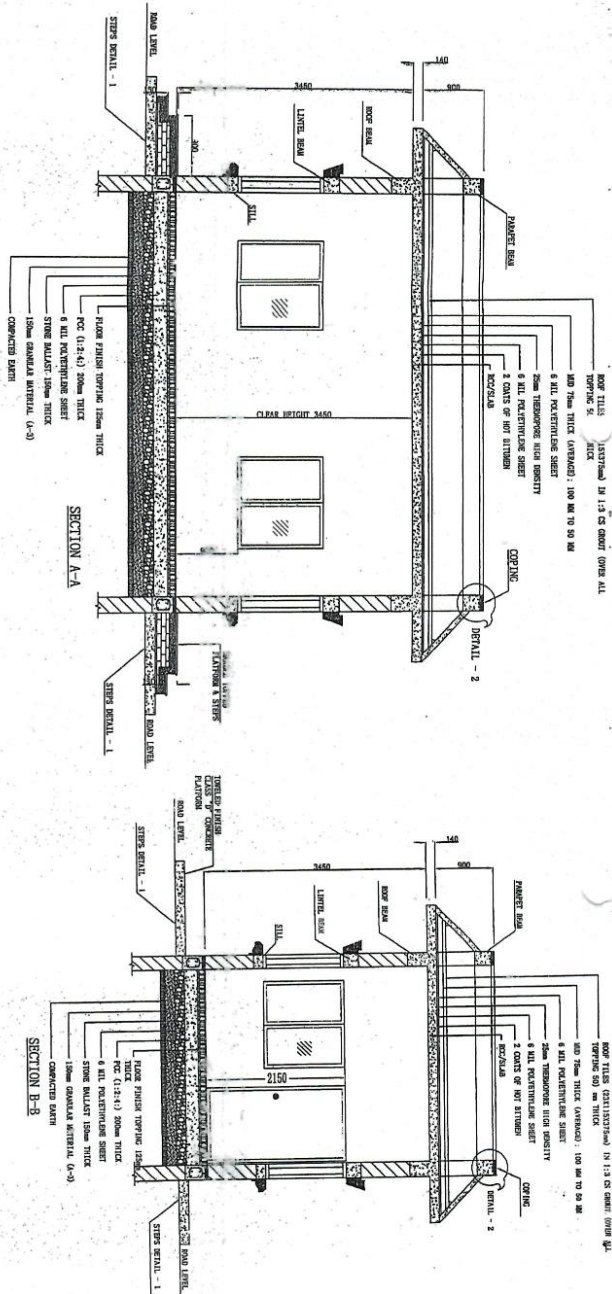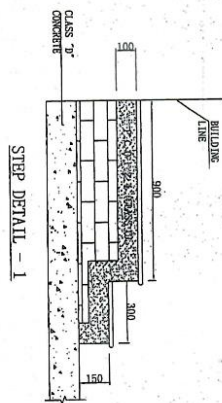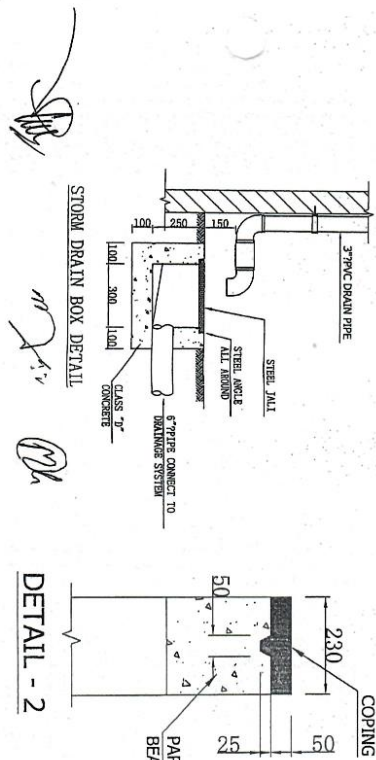



Ref. No. RSAM-4/2A/2017/19

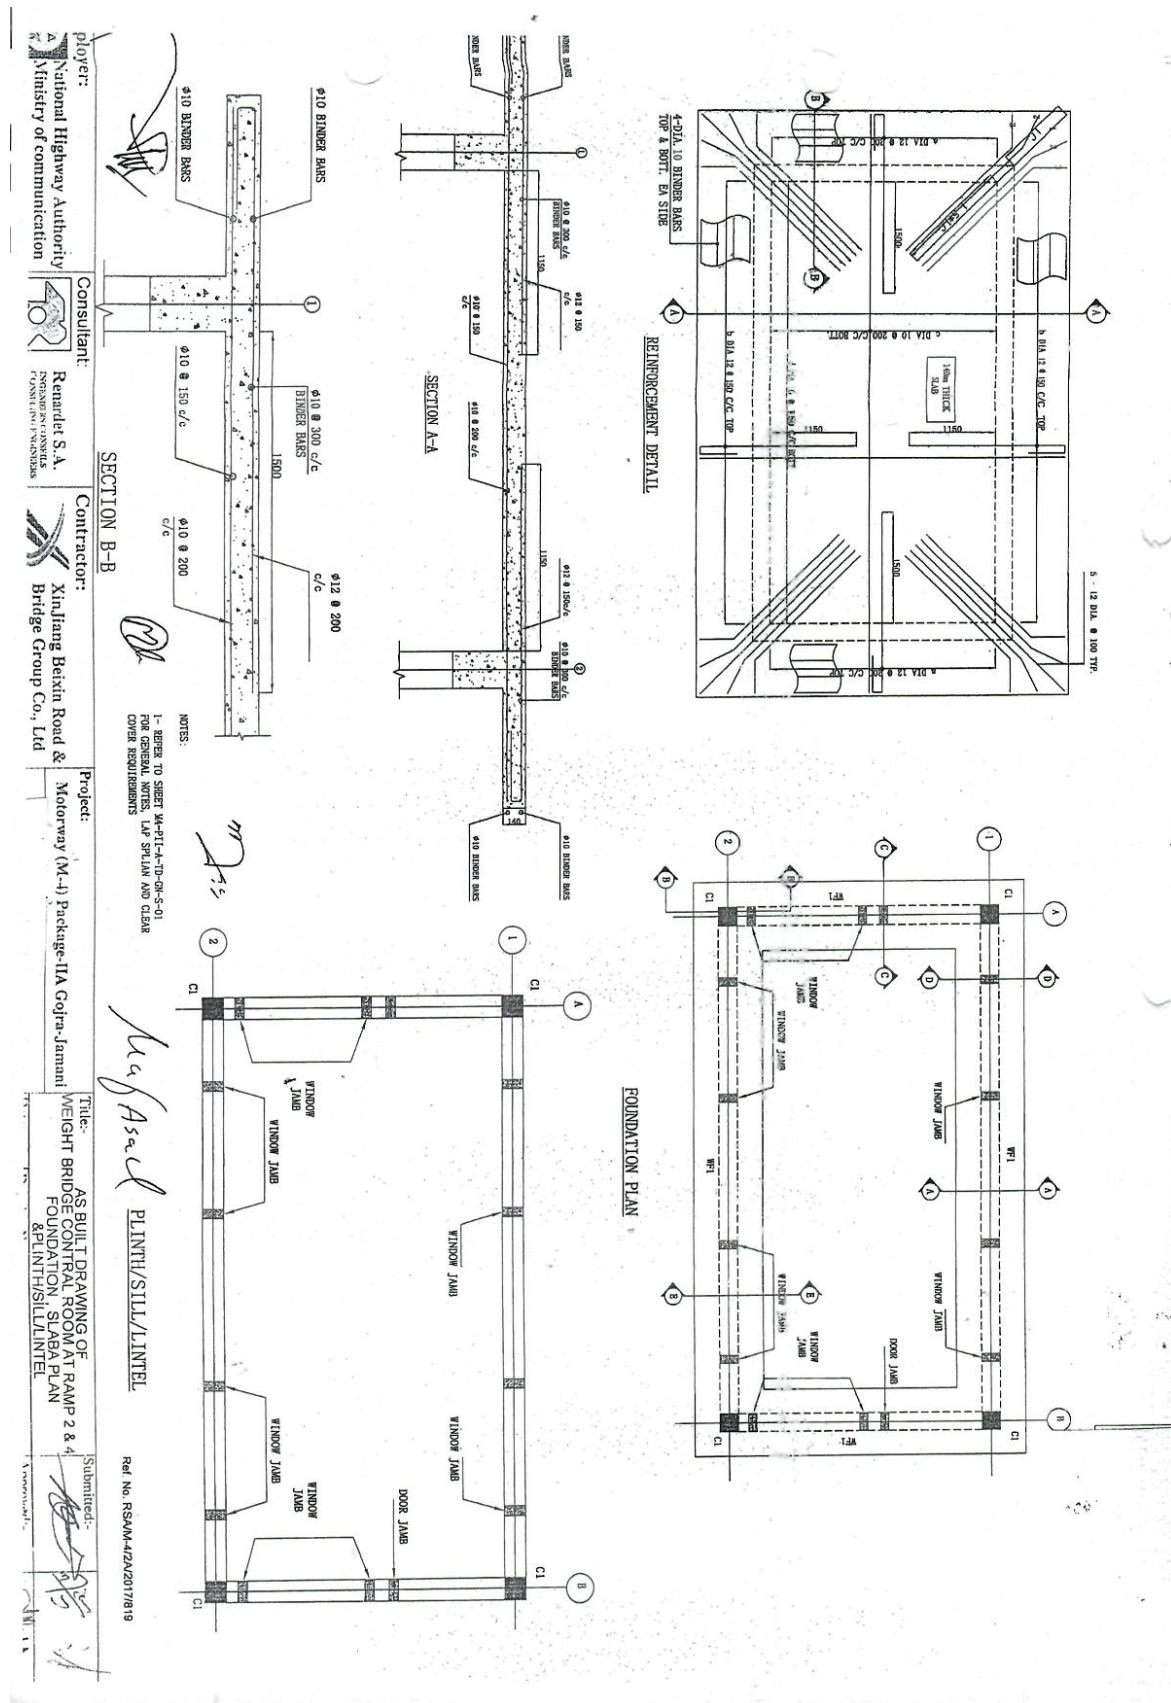

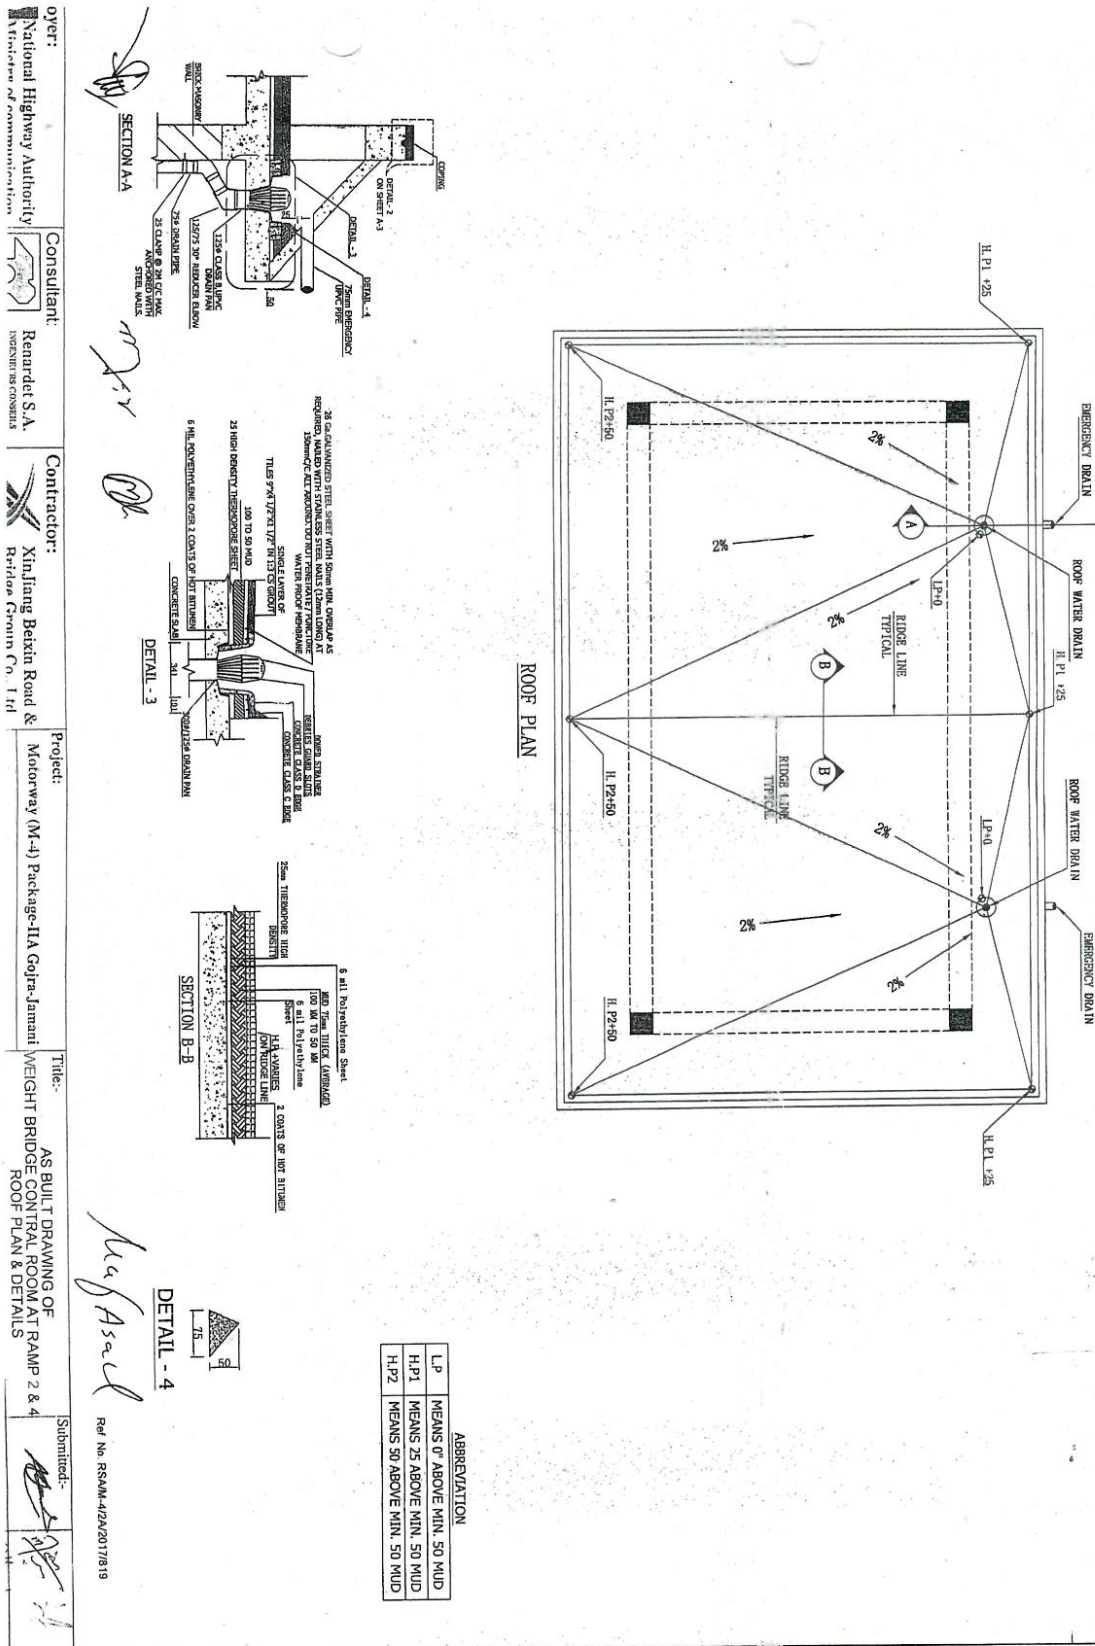




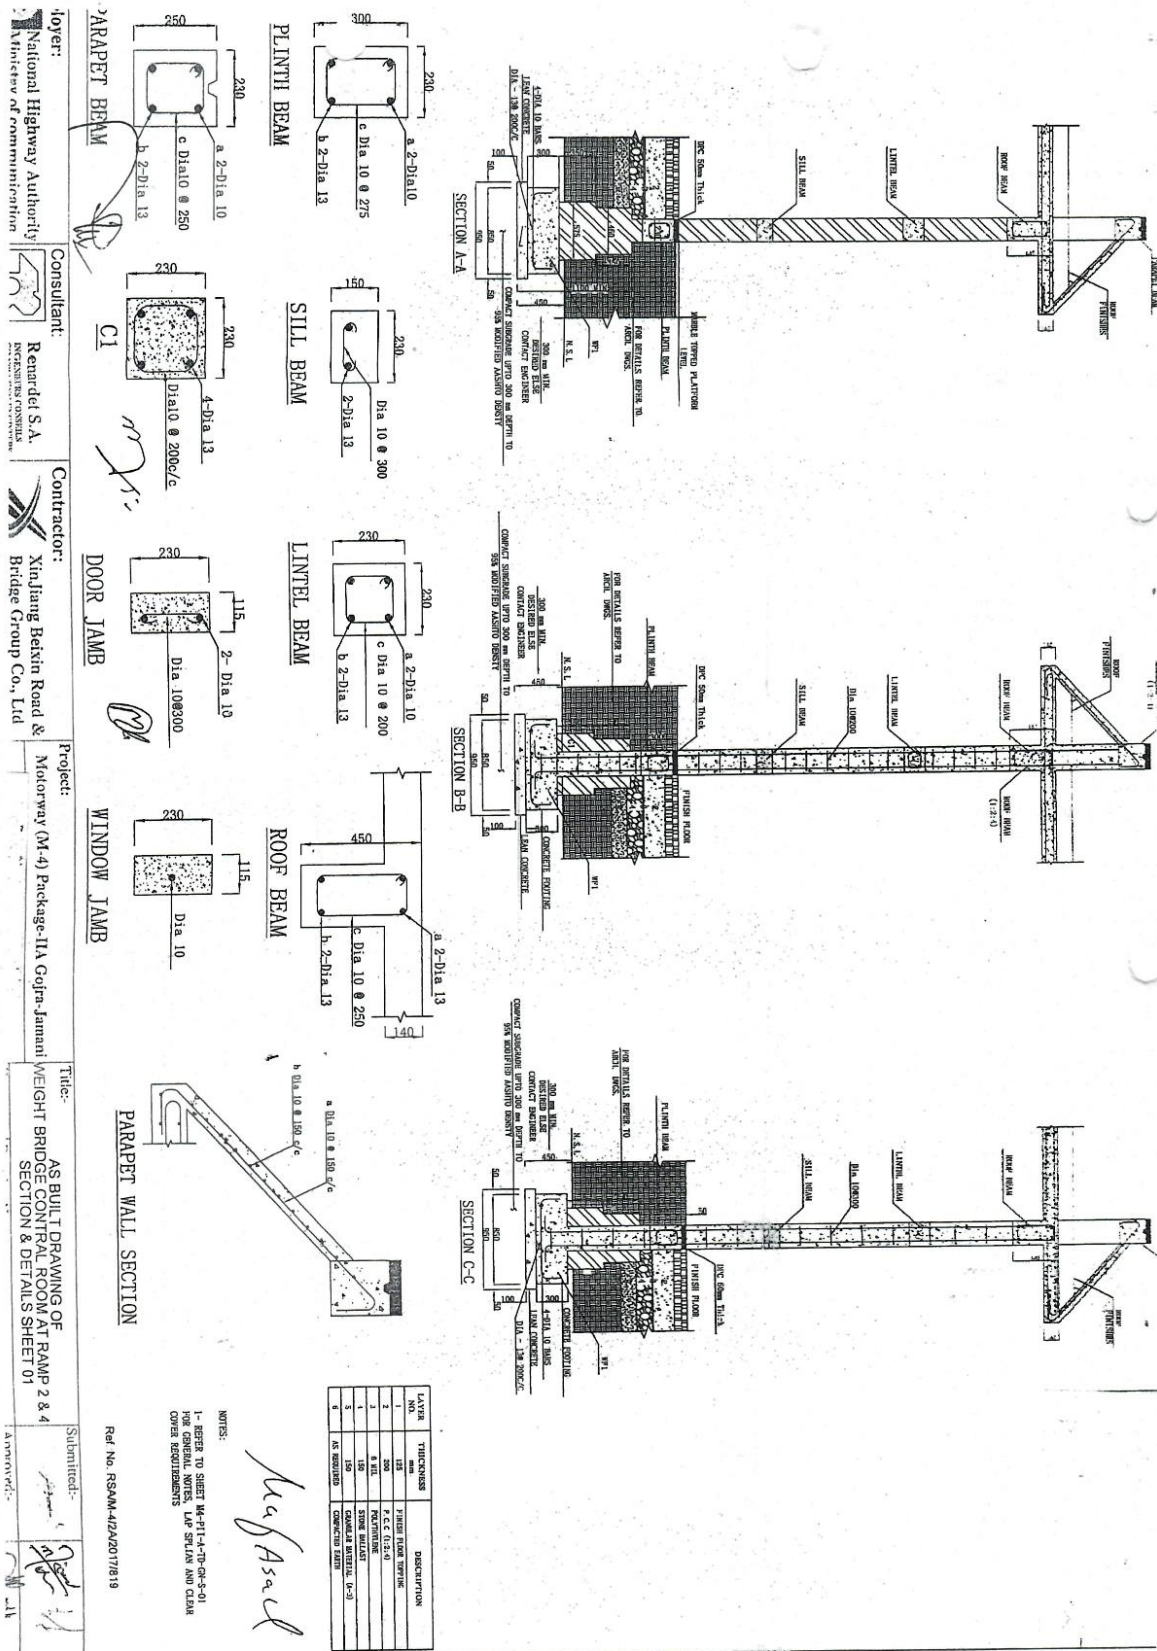

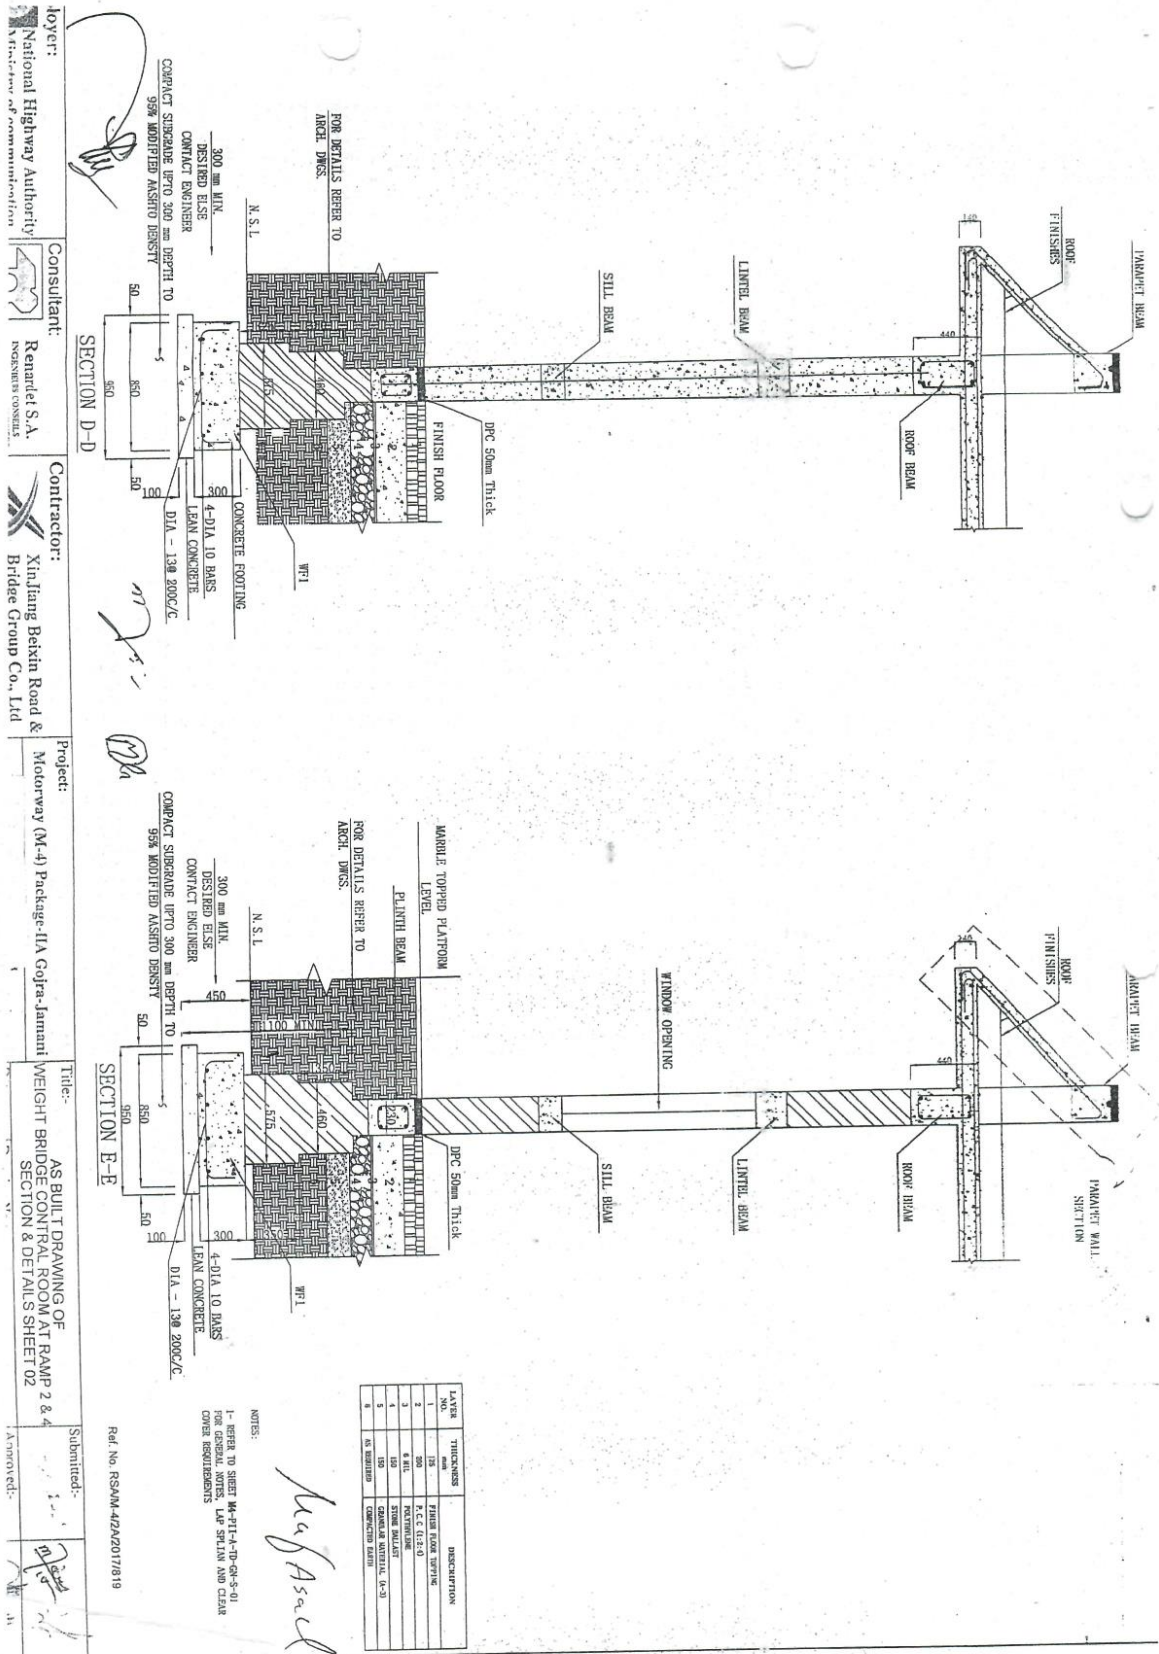





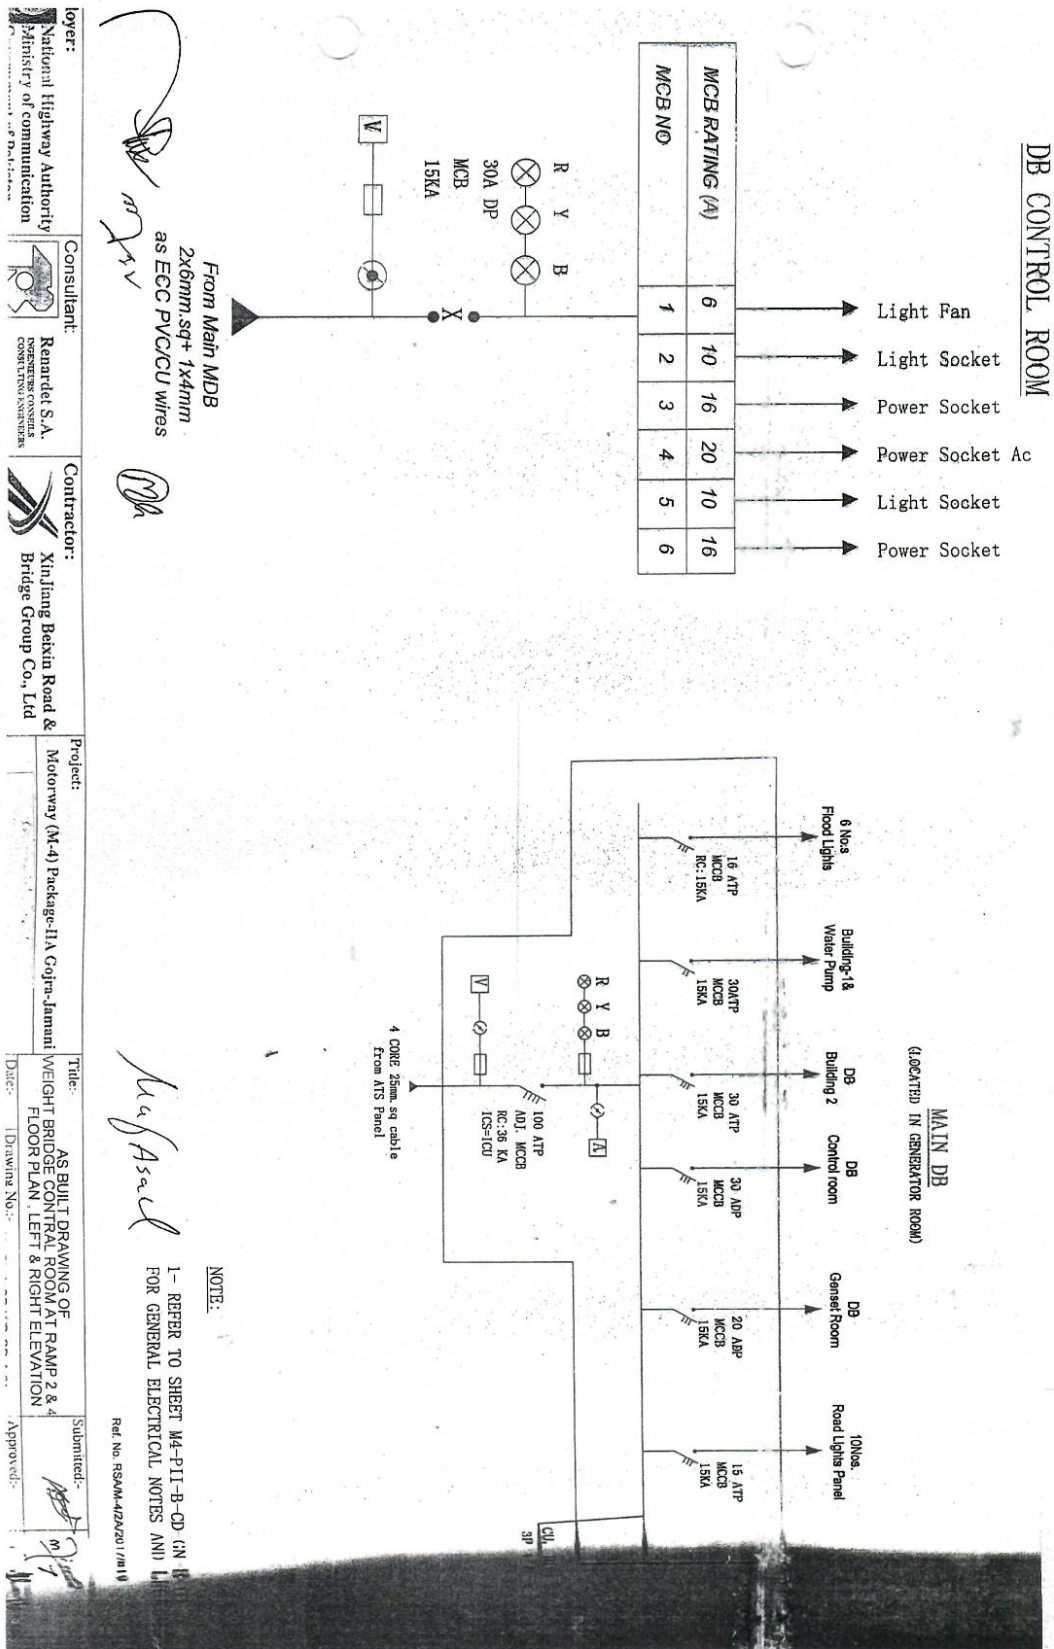

Client:  
National Highway Authority  
Ministry of Communication  
Government of Pakistan

Consultant:  
Remarcel S.A.  
CONSULTING ENGINEERS


Contractor:  
Xinjiang Baixin Road &  
Bridge Group Co., Ltd

Project:  
Motorway (M-4) Package-1/A Gajra-Jamali


Title:  
AS BUILT DRAWING OF OFFICE BUILDING  
PLAN

Submitted:  
Approved:  
Date: 12/01/2019  
Drawing No.: WA-PH-A-D-118-03-A-G


| SCHEDULE OF DOOR & WINDOW |      |           |
|---------------------------|------|-----------|
| S. No.                    | TYPE | SIZE (mm) |
| 1                         | D-1  | 1650X2150 |
| 2                         | D-2  | 900X2150  |
| 3                         | D-3  | 750X2150  |
| 4                         | W-1  | 1200X1230 |
| 5                         | V-1  | 950X1550  |
| 6                         | V-2  | 600X1550  |

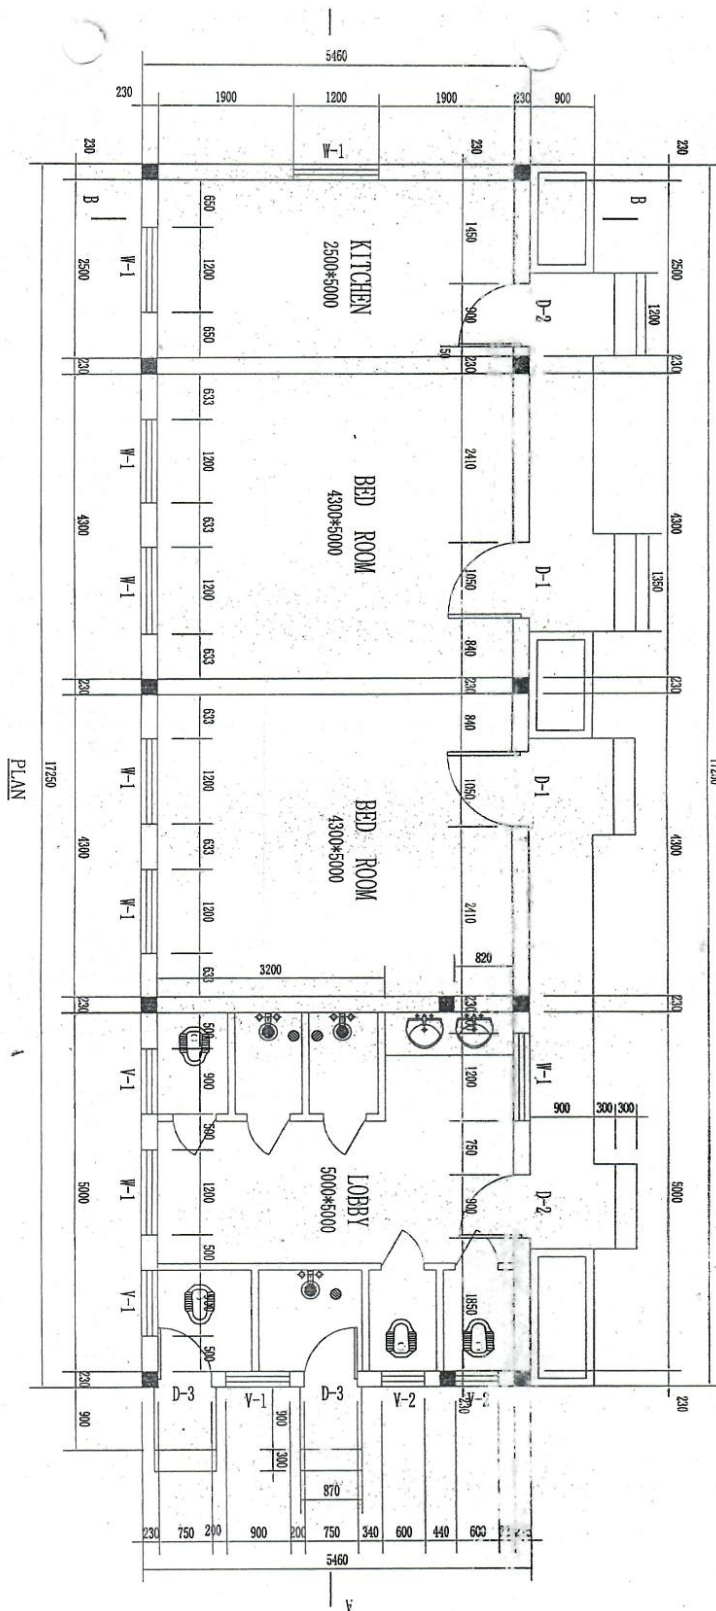



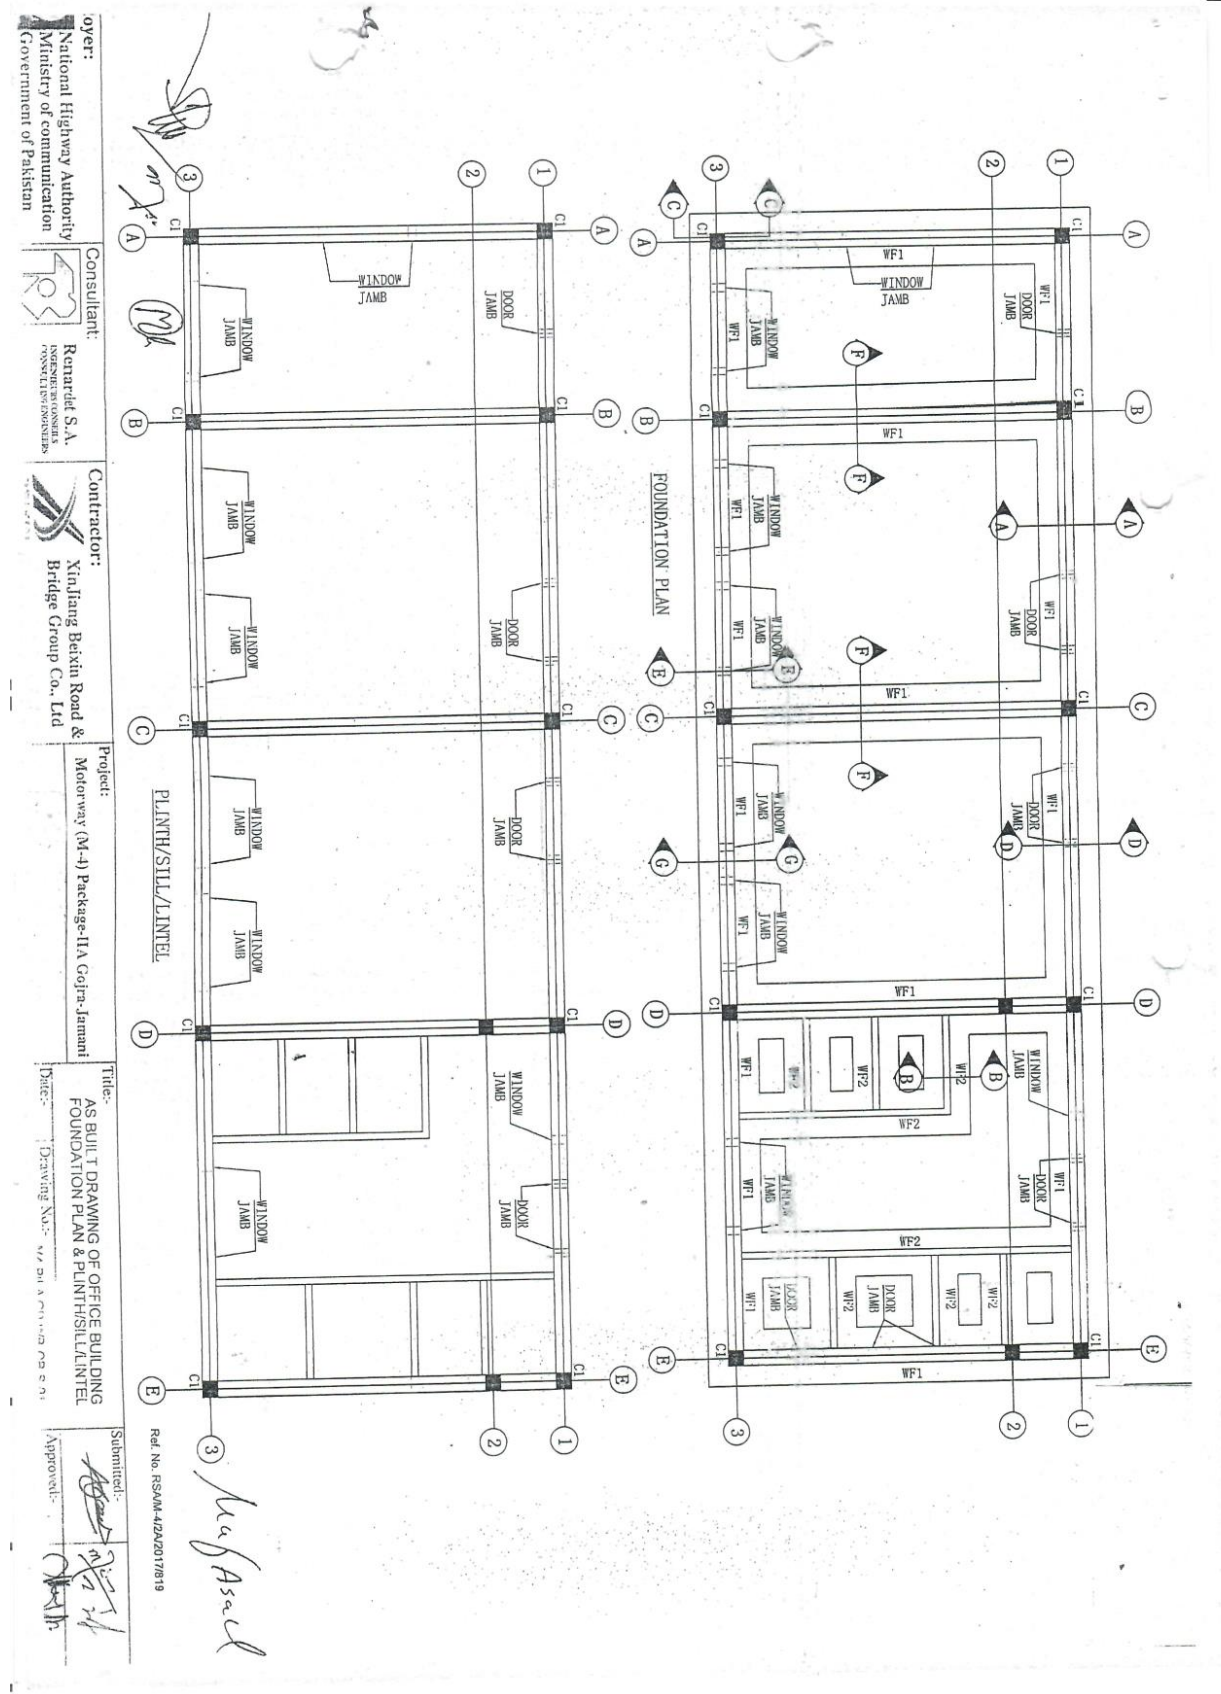


10

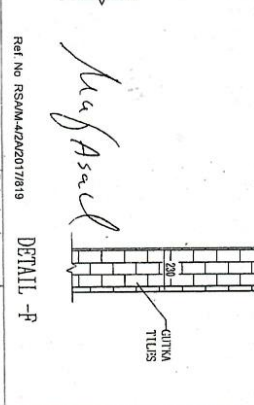



|                                                                                                                    |                                                                                                                                                                                     |                                                                                                                                                                            |                                                                       |                                                                                              |                                                                                                                      |
|--------------------------------------------------------------------------------------------------------------------|-------------------------------------------------------------------------------------------------------------------------------------------------------------------------------------|----------------------------------------------------------------------------------------------------------------------------------------------------------------------------|-----------------------------------------------------------------------|----------------------------------------------------------------------------------------------|----------------------------------------------------------------------------------------------------------------------|
| <p><b>Employer:</b></p> <p>National Highway Authority<br/>Ministry of communication<br/>Government of Pakistan</p> | <p><b>Consultant:</b></p> <p> <b>Renardet S.A.</b><br/>INGENIERS CONSULTANTS<br/>CONSTRUCTEURS</p> | <p><b>Contractor:</b></p> <p> <b>Xinjiang Beixin Road &amp; Bridge Group Co., Ltd</b></p> | <p><b>Project:</b></p> <p>Motorway (M-4) Package-IIA Gofra-Jamami</p> | <p><b>Title:-</b></p> <p><b>AS BUILT DRAWING OF OFFICE BUILDING SECTION &amp; DETAIL</b></p> | <p><b>Submitted:-</b></p> <p></p> |
|                                                                                                                    |                                                                                                                                                                                     |                                                                                                                                                                            | <p><b>DWG:-</b></p> <p>01-02-20-01</p>                                | <p><b>Drawing No.:-</b></p> <p>IM-PH-4-CD-WD-05-A-03</p>                                     | <p><b>Approved:-</b></p> <p></p>  |

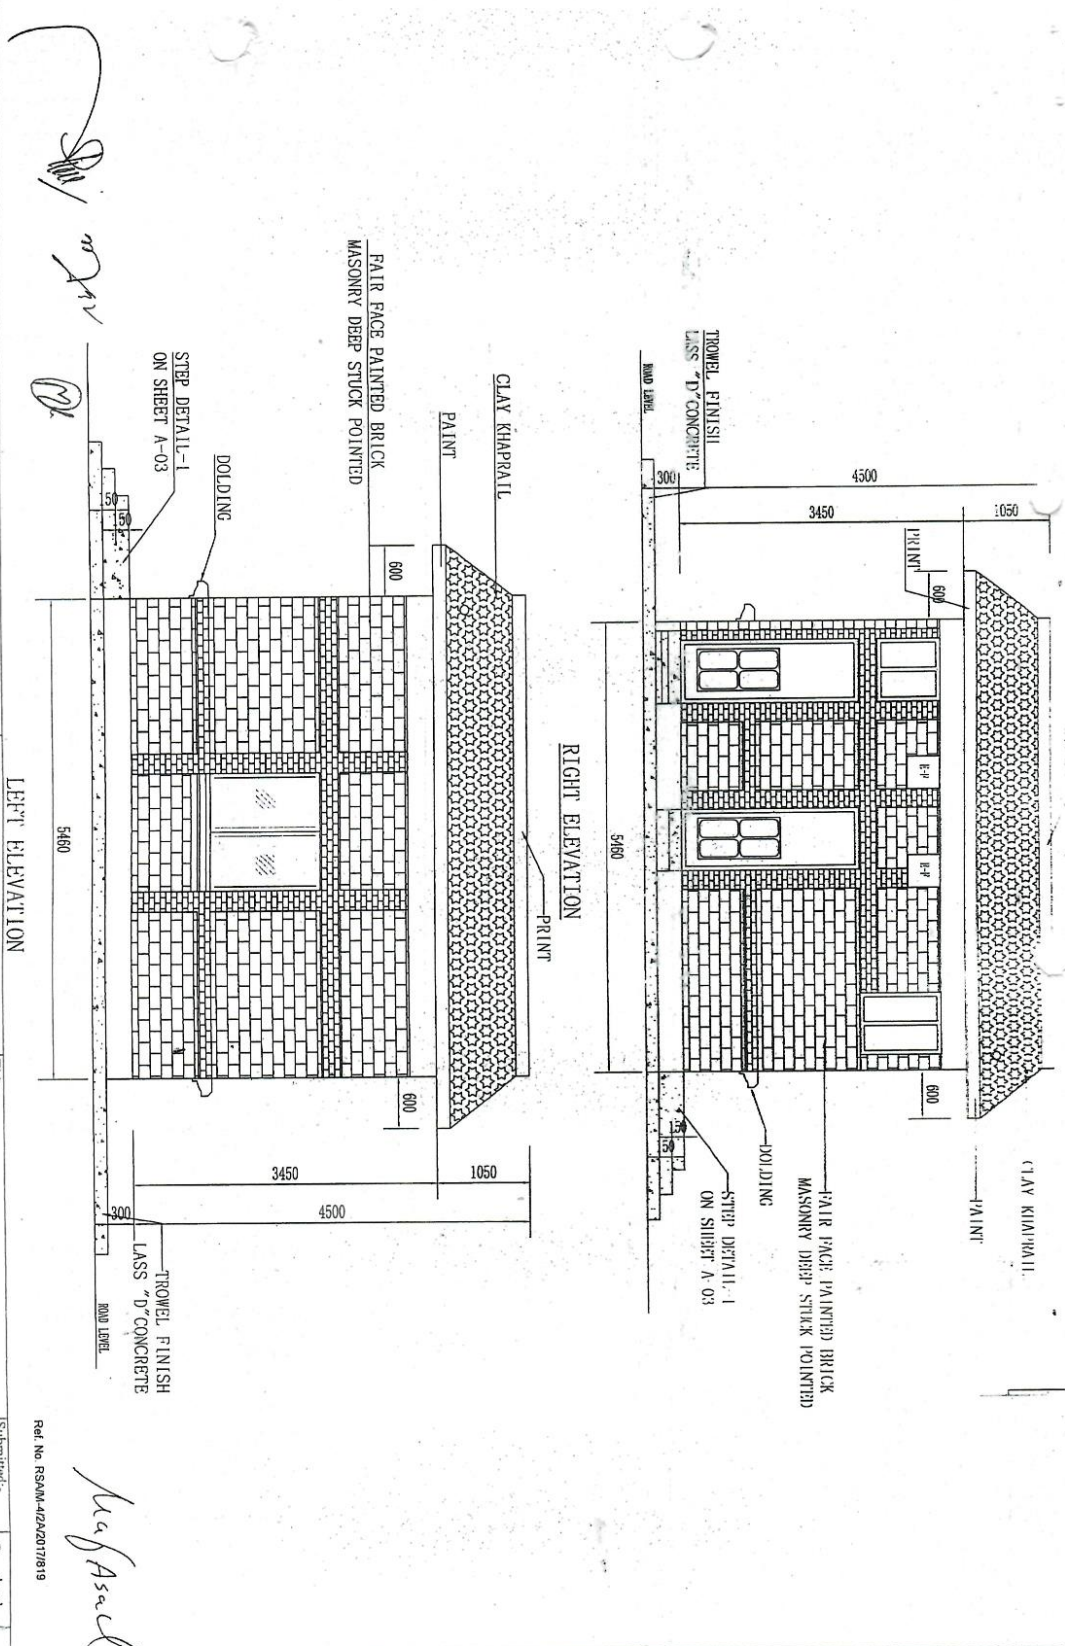



Client:  
National Highway Authority  
Ministry of Communication  
Government of Pakistan

Consultant:  
Remarquet S.A.  
Engineering & Construction  
Consultants

Contractor:  
Xinjiang Beixin Road &  
Bridge Group Co., Ltd

Project:  
Motorway (M-4) Package-IIA Gajra-Jamali

Title:  
AS BUILT DRAWING OF OFFICE BUILDING  
SECTION & DETAIL

Date: 11/07/2019  
Drawing No: 344/PIA/CM/NO/04/04  
Submitted:  
Approved:

